

**BOLIVAR MISSISSIPPI BOARD OF WATER COMMISSIONERS**

**M** 106

GW-5237 SE/NW, Sec. 15 Elev. 135

CODED

8-29-62

**WATER WELL DRILLERS LOG CODED**

Date: 8-29, 1962, Driller: Delta Well Supplies county Bolivar  
(Name)

(1) Owner of Land:	Description & Color of Materials Sand, Clay, Red Clay, Shell, etc.	Thick- ness Feet	Depth Feet
(Name) <u>John R. Dakin</u>	<u>sand clay</u>		<u>22</u>
(Address) <u>R.F.D. Cleveland</u>	<u>F. Sample</u>	<u>4</u>	<u>26</u>
(2) Location: <u>Maddala, Sec. 15</u>	<u>Blue clay</u>	<u>38</u>	<u>64</u>
(distance) <u>1 1/2</u> miles <u>No. East</u> , of <u>Cleveland</u>	<u>F. Sample</u>	<u>4</u>	<u>68</u>
(direction) (Nearest Town)	<u>Clay</u>	<u>2</u>	<u>70</u>
(3) Topography: <input checked="" type="checkbox"/> (Hilly) <input type="checkbox"/> (Flat) <input type="checkbox"/> (Level)	<u>F. Sample</u>	<u>10</u>	<u>80</u>
(4) Purpose of Well: <u>Irrigation</u>	<u>Sand + gravel</u>	<u>40</u>	<u>120</u>
(Domestic, Irrigation, Municipal, Industrial, Other)	<b>CODED</b>		


Information upon completion of well:

- (1) Diameter 12 inches.
- (2) Total Depth 130 feet.
- (3) Water Level 21 feet below top of ground.
- (4) Cased to \_\_\_\_\_, Size \_\_\_\_\_.
- (5) Screen: Size 12, Length 35 ft.
- (6) Were any formations sealed against pollution?  
\_\_\_\_\_ yes,  no.

If YES depth of formation \_\_\_\_\_

Why \_\_\_\_\_

Drillers Remarks: \_\_\_\_\_

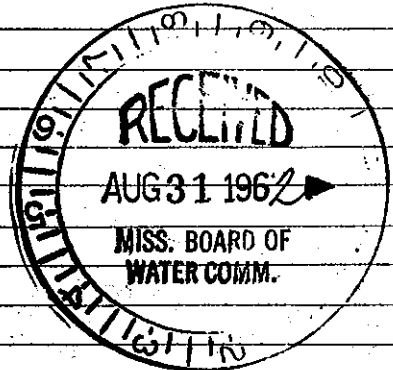

(Use Back Side)

Well No.

Retain this copy for your office files.