

BOLIVAR MISSISSIPPI BOARD OF WATER COMMISSIONERS

M 114
6-15-60

CODED
WATER WELL DRILLERS LOG

M-28

CODED

Date: June 15, 1960, Driller: Layne-Central Co. County Bolivar

(Name)

(1) Owner of Land: Denton Dairy Products, Inc.
(Name)
Cleveland, Mississippi
(Address)

(2) Location: SW 1/4, SE 1/4, Sec. 16 T. 22N R. 5W
behind Denton's Ice House,
miles (distance) of Cleveland (Nearest Town)

(3) Topography: flat
(Hilly) (Flat) (Level)

(4) Purpose of Well: industrial
(Domestic Irrigation, Municipal, Industrial, Other)

Description & Color of Materials Sand, Clay, Red Clay, Shell, etc.	Thick- ness Feet	Depth Feet
Clay	7	7
Fine sand & clay	12	19
Brown sand	20	39
Fine blue sand	26	65
Coarse sand	30	95
Coarse sand & pea gravel	44	139
Hard clay	36	175
Sand & streaks of shale	33	208
Sand	104	312
Shale	18	330
Sand, streaks of shale	50	380
Shale, streaks of sand	124	504
Sand	31	535
Sand with streaks of shale	15	550
Sand	102	652

Information upon completion of well:

(1) Diameter 6" inches.

(2) Total Depth 652 feet.

(3) Water Level 30' feet below top of ground.

(4) Cased to 106' / 504', Size 6" / 4"


(5) Screen: Size 4", Length 30'

(6) Were any formations sealed against pollution?
X yes, no.

If YES depth of formation 606' Packer seal above the screen.

Why

Drillers Remarks:

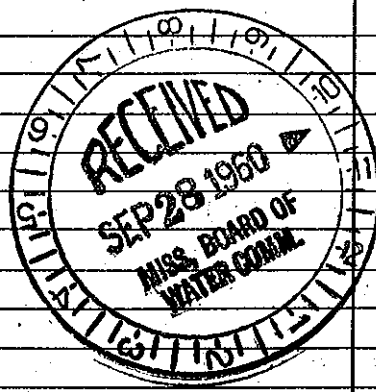

(Use Back Side)

Well No.

1 this copy to Board of Water Commissioners 429 Miss. St. Jackson, Miss.