

BOLIVAR MISSISSIPPI BOARD OF WATER COMMISSIONERS

M 121
7-20-63

WATER WELL DRILLERS LOG

CODED 4

Date: 7/20, 1963, Driller: Delta Well Supply Co. County: Bolivar
(Name)

(1) Owner of Land	Description & Color of Materials Sand, Clay, Red Clay, Shell, etc.	Thick- ness Feet	Depth Feet
Sumner Dairy (Name) Cleveland (Address)	Sand clay Top soil	22	22
(2) Location: 1/4, 1/4, Sec. 15 T22R5W	Fine sand & Blue clay	46	68
1 miles No. East of Cleveland (distance) (direction) (Nearest Town)	Fine to Medium Sand	22	90
(3) Topography: Flat (Hilly) (Flat) (Level)	Sand & Big gravel with Clay shales	47	137
(4) Purpose of Well: Irrigation (Domestic, Irrigation, Municipal, Industrial, Other)	CODED		


Information upon completion of well:

- (1) Diameter 12 inches.
- (2) Total Depth 137 feet.
- (3) Water Level 24 feet below top of ground.
- (4) Cased to _____, Size _____.
- (5) Screen: Size 1/2", Length 40 ft.
- (6) Were any formations sealed against pollution?
_____ yes, _____ no.

If YES depth of formation _____

Why _____

Drillers Remarks: _____

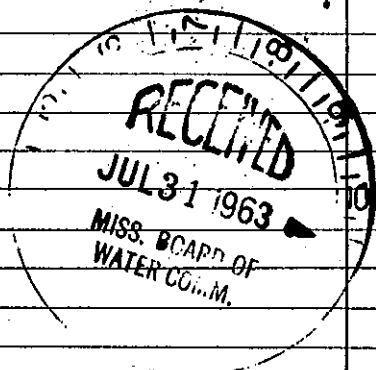

Well No.

(Use Back Side)

Mail this copy to Board of Water Commissioners 429 Miss. St. Jackson, Miss.