

**BOLIVAR MISSISSIPPI BOARD OF WATER COMMISSIONERS**

**M** 122  
**8-28-63**

**WATER WELL DRILLERS LOG**

0022

Date: 8/28, 1963, Driller: Datta Well Drilling Co. County: Bolivar  
 (Name)

(1) Owner of Land: Mrs L.B. Pate & sons  
 (Name)  
RFD, Cleveland  
 (Address)

(2) Location: 1/4, 1/4, Sec. 23 T22R5W  
2 miles to East of Cleveland  
 (distance) (direction) (Nearest Town)

(3) Topography:  (Hilly)  (Flat)  (Level)


(4) Purpose of Well: Domestic  
 (Domestic Irrigation, Municipal, Industrial, Other)

Description & Color of Materials Sand, Clay, Red Clay, Shell, etc.	Thick- ness Feet	Depth Feet
Topsoil	26	
Fine sand	60	86
Sand & gravel	44	130
Clay	110	240
Sand	40	280
Clay	50	330
Gravel <b>CODED</b>	40	370
Clay	40	410
sand gravel	60	470
Clay & shale	30	500
Hard & Fine sand	50	550
Clay & shale	10	560
Gravel clay	35	595
sand	70	665
Clay & shale	50	715
Fine sand	20	735
Misc. "	60	795
Green clay		

Information upon completion of well:

- (1) Diameter 4x2 inches.
- (2) Total Depth 787 feet.
- (3) Water Level 28 feet below top of ground.
- (4) Cased to \_\_\_\_\_, Size \_\_\_\_\_
- (5) Screen: Size 2, Length 25ft
- (6) Were any formations sealed against pollution?  
 \_\_\_\_\_ yes,  no.

If YES depth of formation \_\_\_\_\_  
 Why \_\_\_\_\_  
 Drillers Remarks: \_\_\_\_\_

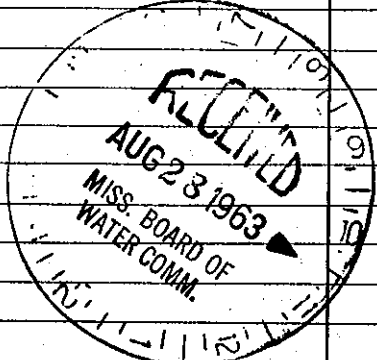

(Use Back Side)

Well No.