

BOLIVAR MISSISSIPPI BOARD OF WATER COMMISSIONERS

M ¹²³
3-5-64

WATER WELL DRILLERS LOG

CODE

Date: 3/5, 1964, Driller: Delta Well & Supply County Bolivar
(Name)

(1) Owner of Land: Lee Odom
(Name)
Cleveland
(Address)

(2) Location: 1/4, 1/4, Sec. 2 T. 52 R. 5,
4 miles N.E., of Cleveland
(distance) (direction) (Nearest Town)

(3) Topography: (Hilly) (Flat) (Level)

(4) Purpose of Well: Domestic
(Domestic Irrigation
Municipal, Industrial, Other)

Description & Color of Materials Sand, Clay, Red Clay, Shell, etc.	Thick- ness Feet	Depth Feet
<u>sand & clay</u>	<u>50</u>	
<u>" "</u>	<u>61</u>	<u>131</u>
<u>Rock</u>	<u>1</u>	<u>132</u>
<u>Clay</u>	<u>5</u>	<u>137</u>
<u>Sand F</u>	<u>175</u>	<u>310</u>
<u>Clay</u>	<u>10</u>	<u>320</u>
<u>Sand F to C</u>	<u>73</u>	<u>393</u>
<u>Clay & shale</u>	<u>213</u>	<u>606</u>
<u>Rock</u>	<u>46</u>	<u>607</u>
<u>shale</u>	<u>71</u>	<u>678</u>
<u>Rock</u>	<u>2</u>	<u>680</u>
<u>Sand M.</u>	<u>5</u>	<u>685</u>
<u>Clay</u>	<u>5</u>	<u>690</u>
<u>Sand Fine</u>	<u>20</u>	<u>710</u>
<u>" Mud</u>	<u>78</u>	<u>788</u>

Information upon completion of well:

(1) Diameter 4x2 inches.


(2) Total Depth 788 feet.

(3) Water Level 22 feet below top of ground.

(4) Cased to _____, Size _____.

(5) Screen: Size 2", Length 20 ft.

(6) Were any formations sealed against pollution?
_____ yes, _____ no.

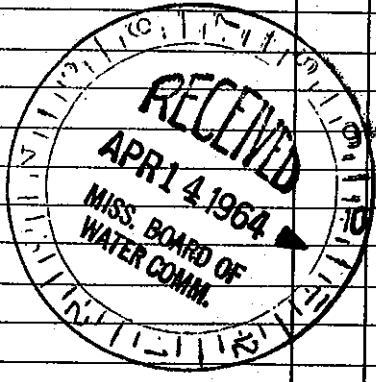

If YES depth of formation _____

Why _____

Drillers Remarks: _____

(Use Back Side)

Well No.