

SOLIVAR MISSISSIPPI BOARD OF WATER COMMISSIONERS

M 124
3-22-64

CODED
WATER WELL DRILLERS LOG

CODED

Date: 3/22, 1964, Drilled Dutton Wells Supply County Solivar
 (Name)

(1) Owner of Land	Description & Color of Materials Sand, Clay, Red Clay, Shell, etc.	Thick- ness Feet	Depth Feet
<u>Albert Ricconi</u> (Name)	<u>Top soil</u>	<u>19</u>	
<u>Cleveland</u> (Address)	<u>Fine sand</u>	<u>8</u>	<u>27</u>
(2) Location: <u>1/4</u> , <u>1/4</u> , Sec. <u>19</u> T <u>22</u> R <u>6</u>	<u>" " Clay</u>	<u>28</u>	<u>55</u>
<u>1/2</u> miles <u>West</u> of <u>Cleveland</u> (distance) (direction) (Nearest Town)	<u>" Sand</u>	<u>10</u>	<u>65</u>
(3) Topography: <input checked="" type="checkbox"/> (Hilly) <input type="checkbox"/> (Flat) <input type="checkbox"/> (Level)	<u>" & gravel</u>	<u>43</u>	<u>108</u>
(4) Purpose of Well: <u>Irrigation</u> (Domestic Irrigation, Municipal, Industrial, Other)	CODED		


Information upon completion of well:

- (1) Diameter 10 inches.
- (2) Total Depth 108 feet.
- (3) Water Level 20 feet below top of ground.
- (4) Cased to _____, Size _____
- (5) Screen: Size 10, Length 38
- (6) Were any formations sealed against pollution?
 _____ yes, _____ no.

If YES depth of formation _____

Why _____

Drillers Remarks: _____

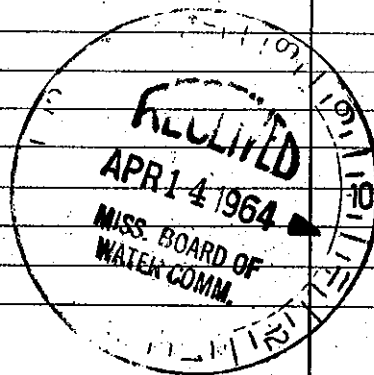

Well No.

(Use Back Side)

Mail this copy to Board of Water Commissioners 429 Miss. St. Jackson, Miss.