

**BOLIVAR MISSISSIPPI BOARD OF WATER COMMISSIONERS**

M 125  
3-31-64

**WATER WELL DRILLERS LOG**

CODED

Date: 3/31, 1964, Driller: Delta Well Supply County Bolivar  
(Name)

(1) Owner of Land:	Description & Color of Materials Sand, Clay, Red Clay, Shell, etc.	Thick- ness Feet	Depth Feet
<u>C. W. Caff Jr.</u> (Name) <u>Cleveland</u> (Address)	<u>Top soil</u>	<u>21</u>	
(2) Location: <u>1/4</u> , <u>1/4</u> , Sec. <u>22</u> T <u>2</u> R <u>5</u>	<u>Fine sand &amp; clay</u>	<u>48</u>	<u>69</u>
<u>1</u> miles <u>S.E.</u> of <u>Cleveland</u> (distance) (direction) (Nearest Town)	<u>" "</u>	<u>11</u>	<u>80</u>
(3) Topography: <input checked="" type="checkbox"/> (Hilly) <input type="checkbox"/> (Flat) <input type="checkbox"/> (Level)	<u>M. sand</u>	<u>15</u>	<u>95</u>
(4) Purpose of Well: _____ (Domestic Irrigation, Municipal, Industrial, Other)	<u>" " Sand</u>	<u>35</u>	<u>130</u>

CODED


Information upon completion of well:

- (1) Diameter 16 inches.
- (2) Total Depth 130'-10" feet.
- (3) Water Level 21 feet below top of ground.
- (4) Cased to \_\_\_\_\_, Size \_\_\_\_\_.
- (5) Screen: Size 16, Length 40.
- (6) Were any formations sealed against pollution?  
\_\_\_\_\_ yes, \_\_\_\_\_ no.

If YES, depth of formation \_\_\_\_\_

Why \_\_\_\_\_

Drillers Remarks: \_\_\_\_\_

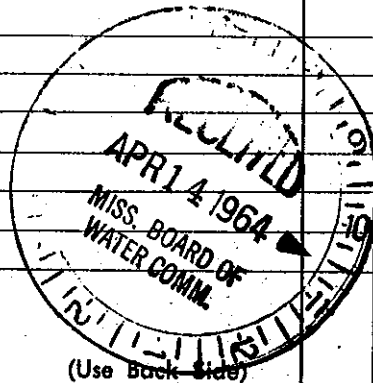

(Use Back Side)

Well No.

Mail this copy to Board of Water Commissioners 429 Miss. St. Jackson, Miss.