

Bolivar
M 128
4-66

MISSISSIPPI BOARD OF WATER COMMISSIONERS

WATER WELL DRILLERS LOG

4/13/66
2180

Date: April 11, 1966, Driller: Layne-Central Company County Bolivar

(Name)

(1) Owner of Land: Cleveland Fisheries (Name)	Description & Color of Materials Sand, Clay, Red Clay, Shell, etc.	Thick- ness Feet	Depth Feet
Cleveland, Mississippi (Address)	Clay	16	16
(2) Location: 1/4, 1/4, Sec. 28 T22N R5W	Fine brown sand	30	46
2 miles south of Cleveland (distance) (direction) (Nearest Town)	Little coarse sand	3	49
(3) Topography: flat (Hilly) (Flat) (Level)	Coarse sand & gravel	33	82
(4) Purpose of Well: irrigation (Domestic Irrigation Municipal, Industrial, Other)	CODED		


Information upon completion of well:

- (1) Diameter 12 inches.
- (2) Total Depth 82 feet.
- (3) Water Level 21 feet below top of ground.
- (4) Cased to 53' 4", Size 12"
- (5) Screen: Size 12", Length 30'
- (6) Were any formations sealed against pollution?
yes, no no.

If YES depth of formation _____

Why _____

Drillers Remarks: _____

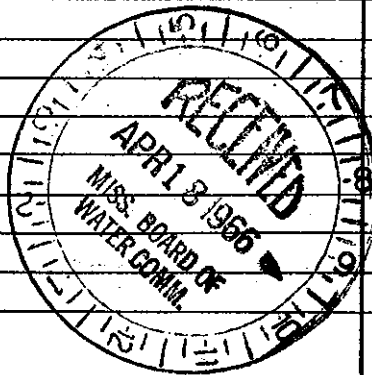

(Use Back Side)

Well No.

Mail this copy to Board of Water Commissioners 429 Miss. St. Jackson, Miss.