

BOARD OF WATER COMMISSIONERS

MSGW 06335

Bolivar  
M 129 WATER WELL DRILLERS LOG

Bolivar

6-66 CODED Date: 6/10, 1966, Driller: Butane Gas Co. CODED County: ~~Jefferson~~

(Name)

(1) Owner of Land: Bern Pruett (Name)	Description & Color of Materials Sand, Clay, Red Clay, Shell, etc.	Thick- ness Feet	Depth Feet
Boyle, Miss. (Address)	Clay	13	13
(2) Location: NE 1/4, NW 1/4, Sec. 32 T14R6W 22 S	Clay	10	23
1/2 miles NW of Boyle (distance) (direction) (Nearest Town)	Fine Sand	10	33
(3) Topography: <input checked="" type="checkbox"/> (Hilly) <input type="checkbox"/> (Flat) <input type="checkbox"/> (Level)	" "	10	43
(4) Purpose of Well: Irrigation (Domestic Irrigation, Municipal, Industrial, Other)	" "	10	53
	Coarse Sand & Gravel	10	63
	" " "	10	73
	" " "	10	83
	" " "	10	93

Information upon completion of well:


CODED

- (1) Diameter 16 inches.
- (2) Total Depth 93 feet.
- (3) Water Level 17 feet below top of ground.
- (4) Cased to 53, Size 16
- (5) Screen: Size 16, Length 40
- (6) Were any formations sealed against pollution?  
yes,  no.

If YES depth of formation \_\_\_\_\_

Why \_\_\_\_\_

Drillers Remarks: \_\_\_\_\_

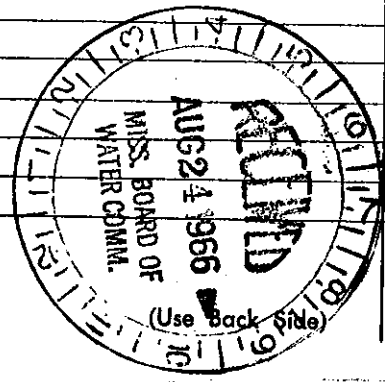

Well No.

tain this copy for your office files.