

Bolivar MISSISSIPPI BOARD OF WATER COMMISSIONERS

M 130 UNDED  
9-66 WATER WELL DRILLERS LOG UNDED

Date: 9/30, 1966, Driller: Delta Well Supply Co. Bolivar  
(Name)

(1) Owner of Land: L. J. Beavers  
(Name)  
RFD Cleveland  
(Address)

(2) Location: SE 1/4, SE 1/4, Sec. 7 T22R6W  
1 miles North of Cleveland  
(distance) (direction) (Nearest Town)

(3) Topography: UNDED  
(Hilly) (Flat) (Level)

(4) Purpose of Well: Domestic  
(Domestic Irrigation  
Municipal, Industrial, Other)

Description & Color of Materials Sand, Clay, Red Clay, Shell, etc.	Thick- ness Feet	Depth Feet
Topsoil	18	18
Fine sand	42	60
Sand & gravel	60	120
Rock	1	121
Fine sand	9	130
Rock	1	131
Clay	25	156
sand & mud	19	175
Clay & shale	275	450
sand & silt	53	503
Clay & shale hard	215	720
Sand med.	70	790

Information upon completion of well:

(1) Diameter 4 1/2 inches.

(2) Total Depth 786 feet.

(3) Water Level 22 feet below top of ground.

(4) Cased to \_\_\_\_\_, Size \_\_\_\_\_.

(5) Screen: Size 2", Length 20 ft.


(6) Were any formations sealed against pollution?  
\_\_\_\_\_ yes,  no.

4" - 126 ft  
Bal. 2" gal pipe  
20 ft ss. screen

If YES depth of formation \_\_\_\_\_

Why \_\_\_\_\_

Drillers Remarks: \_\_\_\_\_

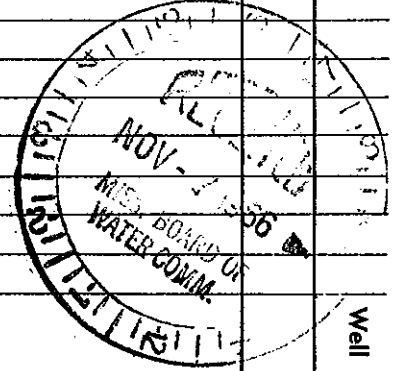

Well No.

(Use Back Side)

Mail this copy to Board of Water Commissioners 429 Miss. St. Jackson, Miss.