

BOLIVAR MISSISSIPPI BOARD OF WATER COMMISSIONERS

M-131
5-21-65

CODED GW-4972

WATER WELL DRILLERS LOG

C1985 6/18/65

Date: May 21, 19 65, Driller: Layne-Central Company County Bolivar

(Name)


(1) Owner of Land: Cleveland Fisheries
(Name)
Cleveland, Mississippi
(Address)
T21N
(2) Location: 1/4, 1/4, Sec. 33 T. R5W
3 miles south of Cleveland
(distance) (direction) (Nearest Town)
(3) Topography: flat
(Hilly) (Flat) (Level)
(4) Purpose of Well: irrigation
(Domestic Irrigation
Municipal, Industrial, Other)

Description & Color of Materials Sand, Clay, Red Clay, Shell, etc.	Thick- ness Feet	Depth Feet
Clay & fill	14	14
Fine sand, clay balls	11	25
White sand	25	50
Blue clay	7	57
Coarse sand, pea gravel	33	90
Gravel, coarse sand	32	122

CODED

Information upon completion of well:

(1) Diameter 16 inches.
(2) Total Depth 122 feet.
(3) Water Level 26'-1" feet below top of ground.
(4) Cased to 72', Size 16"
(5) Screen: Size 16", Length 50'
(6) Were any formations sealed against pollution?
no yes, no no.
If YES depth of formation _____
Why _____
Drillers Remarks: _____

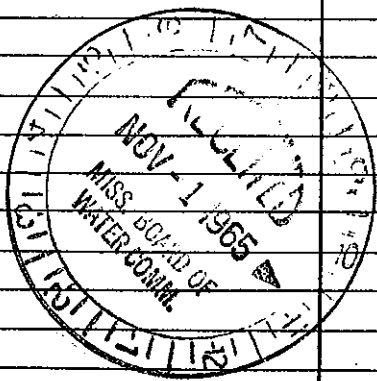

Well No.

(Use Back Side)

Mail this copy to Board of Water Commissioners 429 Miss. St. Jackson, Miss.