

CODED

CODED

MISSISSIPPI
 BOARD OF WATER COMMISSIONERS
 416 North State Street
 Jackson, Mississippi 39201

WATER WELL DRILLERS LOG

Bolivar
M 135
9-67

9/29 1967 Center Well & Supply Co. Bolivar
 date well completed firm name county well located

LANDOWNER:
Robert Masley
R.F.D. Cleveland
 (mailing address)


WELL LOCATION:
 sec. 12 T. 22 N R. 5 W
3 miles to east of Cleveland
 (distance) (direction) (nearest town)

WELL PURPOSE: Home
 (home, irrigation, municipal, industrial)

WELL COMPLETION DATA:

(1) diameter (inches) 4x2
 (2) total depth (feet) 705
 (3) static water level (feet) 27 below top of ground.
 (4) casing gal pipe
 (material) (depth)
 (size) if telescope see back.
 (5) screen 20 ft 655
 (length) (depth to top)
2" Stamers Steel
 (size) (material)
 (6) pump 1 18
 (HP) (yield gpm)
Elec
 (type power)
 (7) electric log _____
 (yes or no)
 (organization running log)
 (8) how well bottom plugged B.P.S. Valve

description of formations encountered	from to	
<u>Top Clay</u>	<u>0</u>	<u>20</u>
<u>fine sand</u>	<u>20</u>	<u>70</u>
<u>sand & gravel</u>	<u>70</u>	<u>130</u>
<u>Clay</u>	<u>130</u>	<u>150</u>
<u>Rock</u>	<u>150</u>	<u>151</u>
<u>loam</u>	<u>151</u>	<u>165</u>
<u>shale hard</u>	<u>165</u>	<u>180</u>
<u>Sand M.</u>	<u>180</u>	<u>290</u>
<u>shale</u>	<u>290</u>	<u>325</u>
<u>sand</u>	<u>325</u>	<u>330</u>
<u>Clay & slate</u>	<u>330</u>	<u>510</u>
<u>Rock</u>	<u>510</u>	<u>562</u>
<u>shale</u>	<u>562</u>	<u>640</u>
<u>sand good</u>	<u>640</u>	<u>705</u>
<u>shale drilled to</u>		<u>740</u>

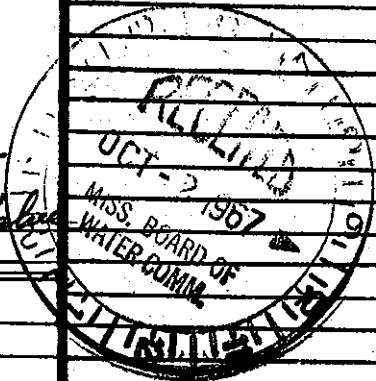

DRILLERS REMARKS: