

CODED

MISSISSIPPI BOARD OF WATER COMMISSIONERS
416 North State Street
Jackson, Mississippi 39201

CODED

WATER WELL DRILLERS LOG

| |
|----------------|
| <i>Bolivar</i> |
| <i>M 143</i> |
| <i>4-26-68</i> |

9/26 date well completed *Delta Well Supply* firm name *Bolivar* county well located

LANDOWNER:
Funches Realty Inc.
Cleveland, Miss.
(mailing address)

| description of formations encountered | from | to |
|---------------------------------------|-------------|------------|
| | <i>Clay</i> | <i>0</i> |
| <i>sand</i> | <i>21</i> | <i>130</i> |

WELL LOCATION:
sec. *28* T. *22* N. R. *5* E
1/2 miles *So* of *Cleveland*
(distance) (direction) (nearest town)


| | | |
|-------------------------|------------|------------|
| <i>Clay</i> | <i>130</i> | <i>222</i> |
| <i>sand</i> | <i>132</i> | <i>272</i> |
| <i>Clay & shale</i> | <i>272</i> | <i>335</i> |
| <i>sand</i> | <i>335</i> | <i>397</i> |

WELL PURPOSE: *Home*
(home, irrigation, municipal, industrial)

| | | |
|--------------|------------|------------|
| <i>Clay</i> | <i>397</i> | <i>418</i> |
| <i>sand</i> | <i>418</i> | <i>459</i> |
| <i>shale</i> | <i>459</i> | <i>470</i> |

WELL COMPLETION DATA:
 (1) diameter (inches) *4 1/2"*
 (2) total depth (feet) *702*
 (3) static water level (feet) *29* below top of ground.
 (4) casing *Galv* (material), *702* (depth)
4 1/2" if telescope see back. (size)
 (5) screen *30* (length), (depth to top)
2 1/2" (size), *Stainless* (material)
 (6) pump *3* (HP), *60* (yield gpm)
Ele (type power)
 (7) electric log *NO* (yes or no)
 (organization running log)
 (8) how well bottom plugged *plugged*

| | | |
|------------------------------|------------|------------|
| <i>sand</i> | <i>470</i> | <i>490</i> |
| <i>Clay sand & shale</i> | <i>490</i> | <i>605</i> |
| <i>SAND</i> | <i>605</i> | <i>702</i> |

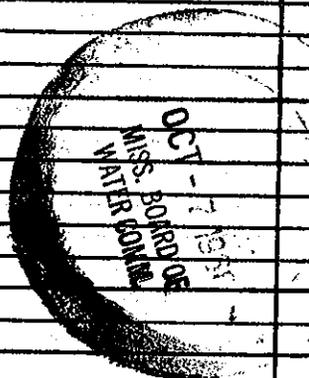

DRILLERS REMARKS: