

BOLIVAR
~~CL-2830~~ **M196**

MISSISSIPPI DEPARTMENT OF NATURAL RESOURCES
 Bureau of Land and Water Resources
 Southport Mall
 P.O. Box 10631
 Jackson, Mississippi 39209
WATER WELL DRILLERS LOG

CODED

8-30 1984 LAYNE-CENTRAL CO. BOLIVAR
 date well completed firm name county well located

LANDOWNER:	description of formations encountered	from	to
TEDDER FARMS			
CLEVELAND, MS	coarse sand/pea gravel	50	75
(mailing address)	coarse sand/gravel	75	122

WELL LOCATION:
 sec. 5 T. 22 N R. 5 W
 ↓ ↓
2 miles N of Cleveland
 (distance) (direction) (nearest town)

CODED

WELL PURPOSE: irrigation
 (home, irrigation, municipal, industrial)

WELL COMPLETION DATA:

(1) diameter (inches) 28"

(2) total depth (feet) 122'

(3) static water level (feet) 38' below top of ground.

(4) casing steel 82'
 (material) (depth)
12" if telescope see back.
 (size)


(5) screen 40' 82'
 (length) (depth to top)
12" st. steel
 (size) (material)

(6) pump 40 1500
 (HP) (yield gpm)
diesel
 (type power)

(7) electric log no
 (yes or no)

(organization running log) st. plate

(8) how well bottom plugged

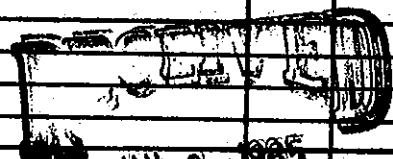

DRILLERS REMARKS:

Department of Natural Resources
 Bureau of Land & Water Resources