

County: Bolivar
 Permit #: GW-43802
 Driller: Cook Drilling Co., Inc.
 Date drilling completed: 4-15-10

State Well Report
 Part 1 - Driller's Log
 Mississippi Department of Environmental Quality
 Office of Land and Water Resources
 P.O. Box 2309
 Jackson, MS 39225
 (601)961-5210
 (601)961-5228 (fax)

For Office Use Only:
 Aquifer: E 251
 Well #: M255
 L. S. Elevation: _____
 E-log #: _____

State Law requires that this report be prepared by the license holder responsible for the work and filed with the Department at the above address within 30 days of completion of drilling of the well or borehole.

Information on Well Owner <i>(Landowner if borehole is not for a water well)</i>	Well or Borehole Location
Owner Name: <u>JTMP Pecore Farms</u>	Latitude: <u>33 44 36</u> Longitude: <u>90 40 03</u>
Mailing Address: <u>180 Cleveland Cir</u>	Method of Lat/Long (circle one): <u>Conventional Survey</u>
<u>Cleveland Ms. 38732</u>	USGS quad, Hand-held GPS, Survey-grade GPS
City State Zip Code	<u>SE 1/4 NW: Sec 24 Twn 22N Rng 5W</u>
Telephone No. <u>(662) 846-6150</u>	Distance Direction Nearest Town
	<u>6 Miles W of Paces ms</u>
	<u>↳ wrong</u>

Well / Borehole Data

Date drilling started: 4-15-10 Date drilling completed: 4-15-10 Hole depth: 120' Hole diameter: 26

Location of the source of any surface water used for drilling: old well

Method of dosing and volume of Chlorine used in drilling and development: _____

Logs run (circle all applicable): No log run Electric Gamma Ray Density Sonic Neutron Other: _____

Name of organization running log(s): _____

Purpose of borehole (check one): Water Well Geotechnical/Geological Investigation Ground Source Heat Pump

Seismic Survey Other (describe) _____

If drilling is not related to water well construction, skip the remainder of this block

Purpose of Well (check one): Home Industrial Public Supply Irrigation Fish Culture Other: _____

If a flowing well, method of flow regulation: Valve _____ Other (describe) _____

Static Water Level: 35 feet above or below (circle one) land surface Date measured: 4-15-10

Method of Measurement (circle one) steel tape electric tape air line other: _____

Well depth: 120 Well grouted to a depth of 10 feet Type of grout (circle one): Neat Cement Bentonite Mix

Casing length: 80 feet Casing diameter: 16" inches Type of casing: PVC

Screen length: 40 feet Screen diameter: 16 inches Type of screen: PVC

Screen slot size: 50 inches Setting depth: From 80 feet to 120 feet

Type of completion (circle all applicable): Gravel packed Underreamed Telescoped Open hole Natural Development

Other (describe): _____

Top of lap pipe or reduction in casing: _____ feet. *If telescoped or more than one screen, describe on next page*


Form: OLWR-SWR-1 (04/08)
RECEIVED
 JUL 13 2010
 BY: OLWR

#25T M255

The sketch below only required for water wells

If well telescopes, show depths on sketch.


Ground Level →

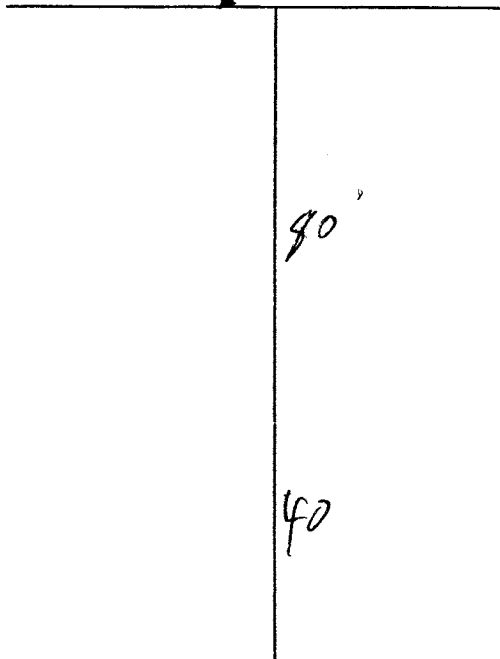

Description of formations encountered must be provided for all wells and boreholes, unless specifically exempted by regulations

Description of Formations Encountered	From (depth)	To (depth)
Clay	Ground Level	35
Sand	35	45
Sand & gravel	45	120

If more than one screen, show location of each on sketch

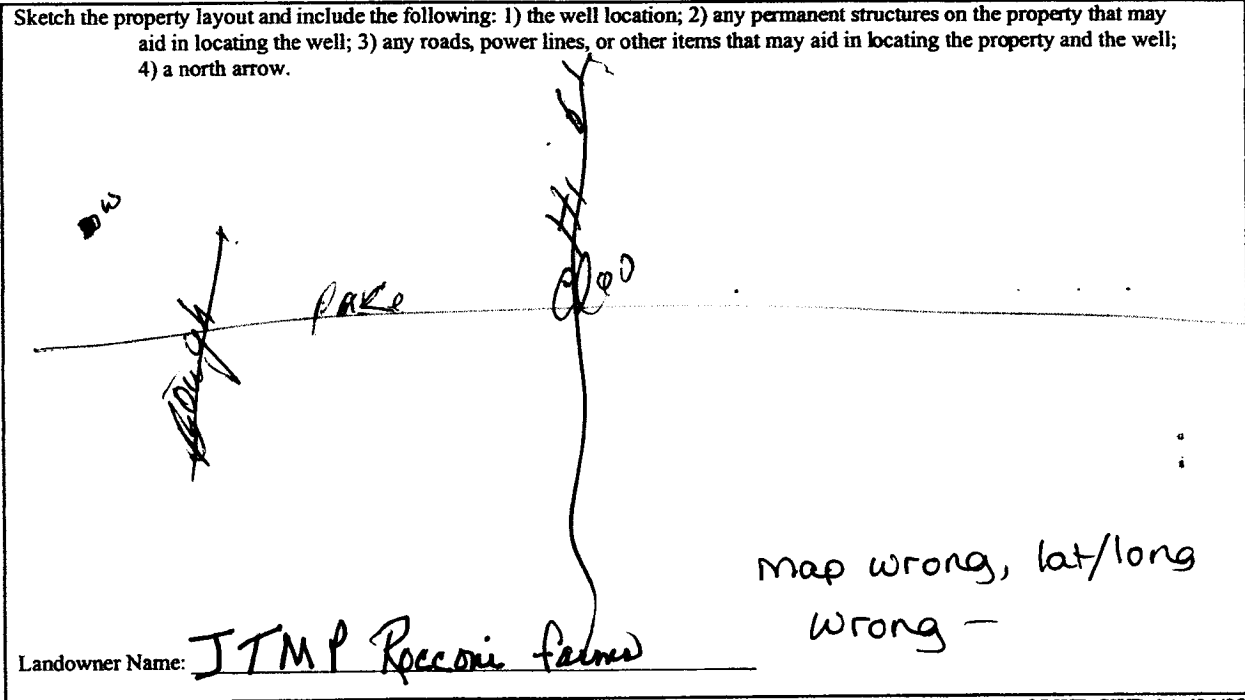

Form: OLWR-SWR-1A (04/08)

I certify that the well/borehole was drilled, constructed, and completed in accordance with all applicable requirements of the Mississippi Department of Environmental Quality and the Mississippi Department of Health regulations, if applicable, and state laws.

COOK Drng. Co., Inc. 289
 Print Name of Responsible Licensee and License No.

4-15-10
 Date

Sidney Cook
 Signature of Licensee

RECEIVED

JUL 18 2010

BY: OLWR

STATE WELL REPORT

Part 2

Pump Installer's Completion Report
 Mississippi Department of Environmental Quality
 Office of Land and Water Resources
 P.O. Box 2309
 Jackson, MS 39225
 (601)961-5210
 (601)961-5228 (fax)

County: Bolivar
 Permit #: G-W-43802
 Driller: Cook Dwg. Co., Inc.
 Date completed: 4-20-10
Copy information from block on Part 1

For Office Use Only:

Aquifer: _____
 Well #: ~~E 251~~
 Elevation: M 255

This part of the report must be completed by a licensed water well contractor or a licensed pump installer. A copy of Part 1 of the report must be attached and both parts filed with the Department at the above address within 30 days of well completion.

Well Owner Information	Well Location
Owner Name: <u>JTMP Pecore farmer</u>	Latitude: 33-49-88 Longitude: 90-55-014
Mailing Address: <u>180 Cleveland Crossing</u>	Method of Lat/Long (check one): Conventional Survey _____
<u>Cleveland Ms. 38732</u>	USGS quad _____, Hand-held GPS _____, Survey-grade GPS _____
City State Zip Code	1/4 1/4 Sec 22 T 23 R 07W
Telephone No. (<u>662</u>) <u>846-6150</u>	Distance <u>SE</u> <u>NW</u> Direction <u>24</u> <u>22N</u> <u>SW</u> Nearest Town
	<u>6</u> Miles <u>W</u> of <u>Pace MS</u>

Pump Type Circle one	Power Type Circle one
Air Lift Jet Submersible	<u>Diesel Engine</u> Gasoline Engine Natural Gas
Bucket Piston <u>Turbine</u>	Electric Motor Hand Tractor PTO
Centrifugal Rotary Flowing Well	Windmill Other (specify): _____
Other (specify): <u>4-20-10</u>	Horse Power Rating of Motor: <u>75</u>
Date Pump Installed: <u>4 20 10</u>	Setting Depth: <u>70</u> feet
Rated Pump Capacity: <u>2200</u> Gallons Per Minute	Number of Stages: <u>1</u>

Pump Test Data	Method of Measuring Water Level Circle one
Date Well Tested: _____	Air Line Electric Measuring Line <u>Steel Tape</u>
Static Water Level (A): <u>38</u> Feet Below Land Surface	Other (specify): _____
Pumping Water Level (B): _____ Feet Below Land Surface	For flowing well, measured shut in head: _____ feet
Drawdown [(B) - (A)]: _____ Feet Below Land Surface	Well yielded _____ GPM with a drawdown of
Test Pumping Rate: _____ Gallons Per Minute	_____ feet after _____ hours of pumping
Duration of Pump Test (minimum 4 hours): _____ hours	

I HEREBY CERTIFY that the above statements are true to the best of my knowledge.

COOK Dwg. Co., Inc. 289 Sidney Cook
 Print Name of Pump Installer and License No. (if applicable) Signature of Pump Installer

Form: OLWR-SWR-1B (04/08)
RECEIVED
JUL 13 2010
BY: OLWR