

MISSISSIPPI DEPARTMENT OF NATURAL RESOURCES

Bureau of Land and Water Resources

Southport Mall

P.O. Box 10631

Jackson, Mississippi 39209

WATER WELL DRILLERS LOG

Permit Applied For BOLIVAN

M274 8041 284

4-5 1988 Dyn Well Bolivar
 date well completed firm name county well located

LANDOWNER Nello GASPARI
RT 2 Box 255
Shaw, MS 38773
 (mailing address)

description of formations encountered	from	to
Clay	0	30
Fine Sand	30	54
Sand + Gravel	54	60
Fine Sand	60	90
Sand + Gravel	90	102
Clay	102	106
Fine Sand	106	115
Sand + Gravel	115	132

WELL LOCATION:
 sec 31 T 21 N R 5 E
3 miles N of SHAW
 (distance) (direction) (nearest town)


WELL PURPOSE: Irrigation
 (home, irrigation, municipal, industrial)

WELL COMPLETION DATA:
 (1) diameter (inches) 16"
 (2) total depth (feet) 132'
 (3) static water level (feet) _____ below/above top of ground.
 (4) casing steel (material), _____ (depth), _____ (size) if telescope see back.
 (5) screen 40 (length), _____ (depth to top), 16 (size), _____ (material)
 (6) pump 60 (HP), _____ (yield gpm), Gen (type power)
 (7) electric log No (yes or no), None (organization running log)
 (8) how well bottom plugged Plate

DRILLERS REMARKS:

If well telescopes please sketch and show depths.

GROUND LEVEL

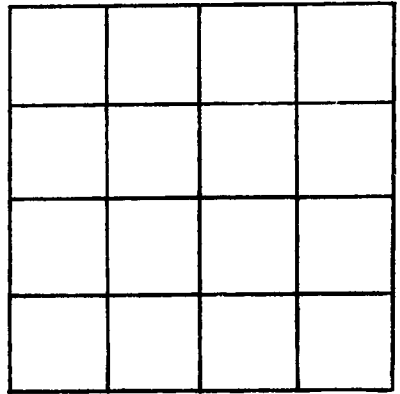

SECTION _____

Please indicate well location X.

ADDITIONAL INFORMATION

If more than one screen, show locations of each on sketch.