

**BOLIVAR MISSISSIPPI BOARD OF WATER COMMISSIONERS**

**M 9006**  
**2-15-62**

**WATER WELL DRILLERS LOG**

*ok*  
*W.H.S.*  
**Bolivar**  
**Mississippi**

Date: Feb. 15, 1962 Driller: Robert E. Ratliff County Lunenburg  
(Name)

(1) Owner of Land: Half Way Grocery  
(Name)  
Cleveland Miss.  
(Address)

(2) Location: 1/4, 1/4, Sec. T R R  
1 miles, of 1  
(distance) (direction) (Nearest Town)

(3) Topography: \_\_\_\_\_  
(Hilly) (Flat) (Level)

(4) Purpose of Well: Domestic  
(Domestic Irrigation  
Municipal, Industrial, Other)

Description & Color of Materials Sand, Clay, Red Clay, Shell, etc.	Thick- ness Feet	Depth Feet
<u>Humble</u>	<u>17</u>	<u>17</u>
<u>Sand</u>	<u>48</u>	<u>65</u>
<u>Gravel</u>	<u>74</u>	<u>139</u>
<u>Clay</u>	<u>1</u>	<u>140</u>
<u>Coarse white sand</u>	<u>47</u>	<u>187</u>
<u>Humble</u>	<u>10</u>	<u>197</u>
<u>Sand</u>	<u>20</u>	<u>217</u>
<u>Humble</u>	<u>2</u>	<u>219</u>
<u>white sand</u>	<u>84</u>	<u>303</u>
<u>Humble</u>	<u>4</u>	<u>307</u>
<u>fine gray sand</u>	<u>170</u>	<u>477</u>
<u>Humble</u>	<u>2</u>	<u>479</u>
<u>Rock</u>	<u>7</u>	<u>486</u>
<u>Humble</u>	<u>118</u>	<u>604</u>
<u>Hard Rock</u>	<u>2</u>	<u>606</u>
<u>Humble</u>	<u>35</u>	<u>641</u>
<u>Sand</u>	<u>26</u>	<u>667</u>

**Information upon completion of well:**

(1) Diameter 6 inches.

(2) Total Depth 667 feet.

(3) Water Level 48 feet below top of ground.

(4) Cased to 6 1/6, Size 2.


(5) Screen: Size 2, Length 15.

(6) Were any formations sealed against pollution?  
Y yes, no.

If YES depth of formation about 15'

Why \_\_\_\_\_

Drillers Remarks: \_\_\_\_\_

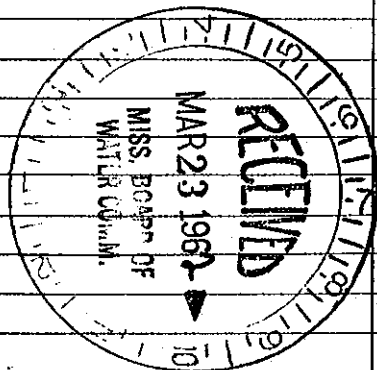

(Use Back Side)

Well No. \_\_\_\_\_

Mail this copy to Board of Water Commissioners 429 Miss. St. Jackson, Miss