

BOLIVAR

N29

12-18-59

MISSISSIPPI BOARD OF WATER COMMISSIONERS

WATER WELL DRILLERS LOG

CODED 166

717

Date: Dec. 18, 19 59, Driller: Layne-Central Company Bolivar County

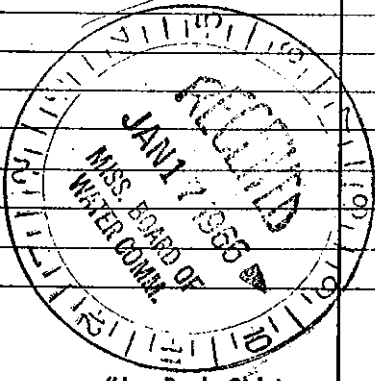
(Name)

District No. 2
 (1) Owner of Land: Bolivar County School
Nugent Center Negro School
Benoit, Mississippi
 (Address)
 (2) Location: 1/4, 1/4, Sec. 17 T21R82
2 miles south of Benoit
 (distance) (direction) (Nearest Town)
 (3) Topography: flat
 (Hilly) (Flat) (Level)
 (4) Purpose of Well: domestic
 (Domestic Irrigation
 Municipal, Industrial, Other)

Description & Color of Materials Sand, Clay, Red Clay, Shell, etc.	Thick- ness Feet	Depth Feet
Clay	16	16
Fine sand	14	30
Coarse sand	35	65
Coarse sand & pea gravel	61	126
Clay	13	139
Rock	1	140
Hard shale	44	184
Sandy shale	46	230
Hard shale	60	290
Sandy shale	90	380
Hard shale	45	425
Sandy shale	35	460
Fine sand & shale	20	480
Fine sand	64	544
Shale	5	549

CODED

Information upon completion of well:
 (1) Diameter 6 1/4 inches.
 (2) Total Depth 547 feet.
 (3) Water Level 28 feet below top of ground.
 (4) Cased to 497', Size 6"
20' lap
 (5) Screen: Size 4", Length 41'
9' of 4" blank
 (6) Were any formations sealed against pollution?
yes yes, no no.
 If YES depth of formation Cemented to top,
 has mechanical seal and B.P.V.
 Why _____
 Drillers Remarks: _____
75 GPM.
Electric power.

497 547
 558
 497 547

 (Use Back Side)

Well No.

Mail this copy to Board of Water Commissioners 429 Miss. St. Jackson, Mi