

BOLIVAR

N 31

7-30-59

MISSISSIPPI BOARD OF WATER COMMISSIONERS

WATER WELL DRILLERS LOG

1/13/66
CODED 39

Date: July 30, 1959, Driller: Layne-Central Company County Bolivar

(Name)

(1) Owner of Land: Benoit Outing Club

(Name)

Benoit, Mississippi

(Address)

(2) Location: 1/4, 1/4, Sec. 5 T7R8,

 miles of Benoit
(distance) (direction) (Nearest Town)

(3) Topography: flat

(Hilly) (Flat) (Level)

(4) Purpose of Well: domestic

(Domestic Irrigation
Municipal, Industrial, Other)

Description & Color of Materials Sand, Clay, Red Clay, Shell, etc.	Thick- ness Feet	Depth Feet
Sandy clay	8	8
Blue clay	39	47
Fine sand	18	65
Coarse sand	30	95
Coarse sand & pea gravel	39	134
Clay	20	154
Fine sand	21	175
Shale	75	250
Rock	4	254
Shale	165	419
Sand P.K. medium	44	463
Sand	18	481

Information upon completion of well:

(1) Diameter 4x3 inches.

(2) Total Depth 481 feet.

(3) Water Level 27' feet below top of ground.

(4) Cased to 355' 11" Size 3"
105' 11" of 3" blank
3' 2" of 3" blank

(5) Screen: Size 3", Length 20'

(6) Were any formations sealed against pollution?

yes yes, no.


If YES depth of formation Packer above the
screen and B.P.V.

Why

Drillers Remarks:

15 GPM.

CODED

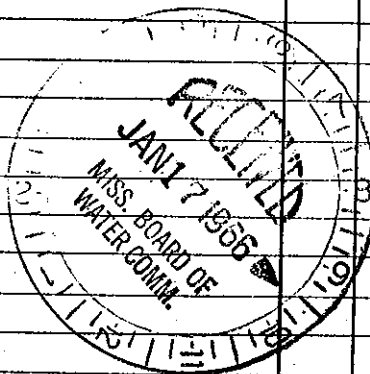

Well No.

(Use Back Side)

Mail this copy to Board of Water Commissioners 429 Miss. St. Jackson, Mi