

BOLIVAR MISSISSIPPI BOARD OF WATER COMMISSIONERS

N 32

WATER WELL DRILLERS LOG

N-7

12-1-60

Date: 12/1, 1960, Driller: Bailey Drilling
(Name)

CODED

BOLIVAR Washington

(1) Owner of Land: <u>Terrell Patterson</u> (Name) <u>Benoit, Miss.</u> (Address)	Description & Color of Materials Sand, Clay, Red Clay, Shell, etc.	Thick- ness Feet	Depth Feet
	<u>Clay</u>	<u>20</u>	<u>20</u>
	<u>Sand</u>	<u>65</u>	<u>85</u>
	<u>Sand + gravel</u>	<u>30</u>	<u>115</u>
	<u>Mud</u>	<u>163</u>	<u>278</u>
	<u>Sand</u>	<u>54</u>	<u>332</u>
	<u>Mud</u>	<u>103</u>	<u>435</u>
	<u>Fine Sand</u>	<u>20</u>	<u>455</u>
	<u>Sand + Mud spotted</u>	<u>125</u>	<u>580</u>
	<u>Sand</u>	<u>22</u>	<u>602</u>

(2) Location: 30 248
2 miles SE of Benoit
(distance) (direction) (Nearest Town)

(3) Topography: Flat
(Hilly) (Flat) (Level)

(4) Purpose of Well: domestic
(Domestic Irrigation
Municipal, Industrial, Other)

Information upon completion of well:


- (1) Diameter 2 1/2 x 2 inches.
- (2) Total Depth 596 feet.
- (3) Water Level _____ feet below top of ground.
- (4) Cased to all way Size 2 1/2 x 2
- (5) Screen: Size 2, Length 10 ft.
- (6) Were any formations sealed against pollution?
_____ yes, X no.

If YES depth of formation _____

Why _____

Drillers Remarks: _____

CODED

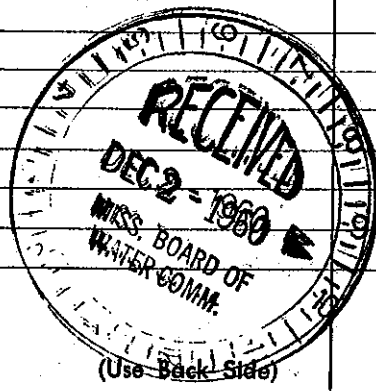

Well No. _____

Mail this copy to Board of Water Commissioners 429 Miss. St. Jackson, Miss.