

BOLIVAR MISSISSIPPI BOARD OF WATER COMMISSIONERS

N 34

5-10-63

WATER WELL DRILLERS LOG

Bolivar

Date: *5/10*, 1963, Driller: *Biley Drilling Co. Washington*

CODED

(1) Owner of Land:	Description & Color of Materials Sand, Clay, Red Clay, Shell, etc.	Thick- ness Feet	Depth Feet
<i>Ferrell Patterson</i> (Name) <i>Benoit Miss.</i> (Address)	<i>Clay</i>		<i>10</i>
(2) Location: $\frac{1}{4}$, $\frac{1}{4}$, Sec. <i>30</i> T21 R8,	<i>Gravel</i>		<i>45</i>
<i>3</i> miles <i>SE</i> , of <i>Benoit</i> (distance) (direction) (Nearest Town)			<i>105</i>
(3) Topography: <i>Flat</i> (Hilly) (Flat) (Level)			
(4) Purpose of Well: <i>Irrigation</i> (Domestic Irrigation Municipal, Industrial, Other)			

Information upon completion of well:


- (1) Diameter *16* inches.
- (2) Total Depth *105* feet.
- (3) Water Level *14* feet below top of ground.
- (4) Cased to *all way* Size *16*
- (5) Screen: Size *16"*, Length *50 ft.*
- (6) Were any formations sealed against pollution?
 yes, no.

If YES depth of formation _____

Why _____

Drillers Remarks: _____

CODED

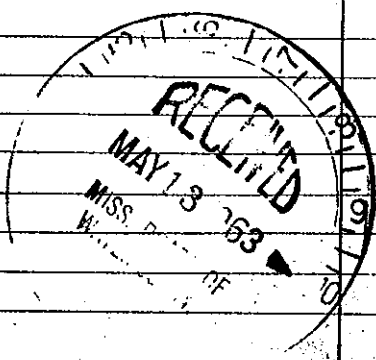

(Use Back Side)

Well No.

Mail this copy to Board of Water Commissioners 429 Miss. St. Jackson, Miss