

BOLIVAR
N 35
3-3-66

MISSISSIPPI BOARD OF WATER COMMISSIONERS

WATER WELL DRILLERS LOG

3/17/66
 C 2133

CODED

Date: March 3, 1966, Driller: Layne-Central Company Bolivar

(Name)

(1) Owner of Land: Ralph W. Ray
 (Name)
Benoit, Mississippi
 (Address)

(2) Location: 1/4, 1/4, Sec. 8 T21R2,
west of Community of Bolivar
miles, of
 (distance) (direction) (Nearest Town)

(3) Topography: flat
 (Hilly) (Flat) (Level)

(4) Purpose of Well: irrigation
 (Domestic Irrigation
 Municipal, Industrial, Other)

Description & Color of Materials Sand, Clay, Red Clay, Shell, etc.	Thick- ness Feet	Depth Feet
Fine gray sand	22	22
Coarse sand	12	34
Clay	5	39
Fine sand	9	48
Sand clay	5	53
Coarse sand	1	54
Coarse sand, pea gravel	18	72
Fine sand	2	74
Coarse sand	8	82
Coarse sand, pea gravel	5	87
Fine sand, wood	8	95
Bottomed out wood, fine sand	5	100

Information upon completion of well:

(1) Diameter 12 inches.

(2) Total Depth 100 feet.

(3) Water Level 10 feet below top of ground.

(4) Cased to 53', Size 12"

(5) Screen: Size 12", Length 50'


(6) Were any formations sealed against pollution?
no yes, no no.

If YES depth of formation _____

Why _____

Drillers Remarks: _____

CODED

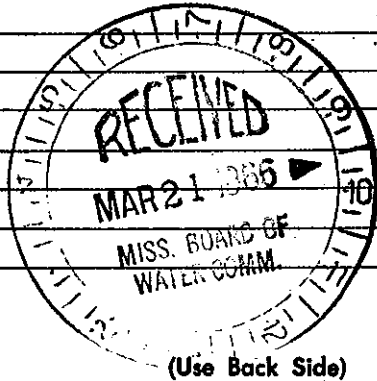

Well No.

Mail this copy to Board of Water Commissioners 429 Miss. St. Jackson, Miss