

CODED

CODED

MISSISSIPPI
 BOARD OF WATER COMMISSIONERS
 416 North State Street
 Jackson, Mississippi 39201

WATER WELL DRILLERS LOG

Bolivar
N 60
2-67

2/10 1967 Bailey Drilling Co Bolivar
 date well completed firm name county well located

LANDOWNER: D M Beadel
R 1, Box 43
Bentley, Miss. 38726
 (mailing address)

WELL LOCATION:
 sec. 35 T 21 N R. 8 W
4 miles N of Benoit
 (distance) (direction) (nearest town)


WELL PURPOSE: Home
 (home, irrigation, municipal, industrial)

WELL COMPLETION DATA:

- (1) diameter (inches) 4 x 2
- (2) total depth (feet) 431
- (3) static water level (feet) 25' below top of ground.
- (4) casing Galv, 421,
 (material) (depth)
4x2 if telescope see back.
 (size)
- (5) screen 10', 421
 (length) (depth to top)
2", Stainless Steel
 (size) (material)
- (6) pump 3/4, 15
 (HP) (yield gpm)
Sub
 (type power)
- (7) electric log No
 (yes or no)
 (organization running log)
- (8) how well bottom plugged wash
valve

description of formations encountered	from to	
	from	to
Clay	0	31
Sand	31	100
Gravel	100	109
Hard rock	109	110
Mud	110	115
Soft rock	115	116
Mud	116	302
Sand	302	307
Mud	307	353
Soft rock	353	354
Mud	354	388
Fine Sand	388	410
Medium Sand	410	431

CODED

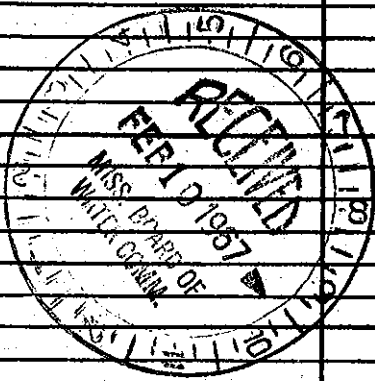

DRILLERS REMARKS: