

Bolivar
N 61
3-67

CODED

CODED

MISSISSIPPI
BOARD OF WATER COMMISSIONERS
416 North State Street
Jackson, Mississippi 39201

WATER WELL DRILLERS LOG

3-4 1967 Franklin County James Lee Bolivar
date well completed firm name county well located

LANDOWNER: Hees farm
Bessie miss
(mailing address)


WELL LOCATION:
sec. 34 T21 N R. 8 W
1 miles N of Bessie
(distance) (direction) (nearest town)

WELL PURPOSE: irrigation
(home, irrigation, municipal, industrial)

WELL COMPLETION DATA:
(1) diameter (inches) 6
(2) total depth (feet) 138.6
(3) static water level (feet) 19 ^{below} above top of ground.
(4) casing Pipe 90³
(material) (depth)
6 If telescope see back.
(size)
(5) screen 48 90³
(length) (depth to top)
6 Doerr
(size) (material)
(6) pump 30 1000
(HP) (yield gpm)
Wester
(type power)
(7) electric log no
(yes or no)
(organization running log)
(8) how well bottom plugged Welder

description of formations encountered	from	to
Top Soil. Buckshot		14
Yellow Clay & fine sand	6 1/2	20 1/2
fine sand	32 1/2	53
MED SAND	6 1/2	59 1/2
MED SAND & gravel	6 1/2	66
Sand & gravel	6 1/2	72 1/2
MED SAND	13	85 1/2
Sand & gravel	6 1/2	92
MED SAND	6 1/2	98 1/2
Sand clay & gravel	6 1/2	105
Clay	6 1/2	111 1/2
Sand & gravel	26	137 1/2
Clay	6 1/2	144

CODED

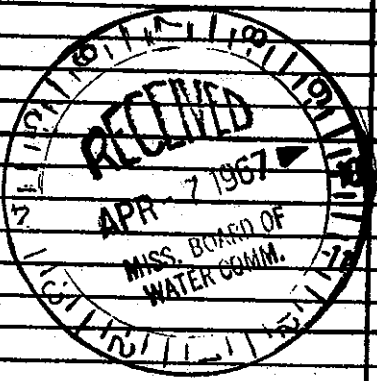

DRILLERS REMARKS: