

CODED

CODED

MISSISSIPPI  
 BOARD OF WATER COMMISSIONERS  
 416 North State Street  
 Jackson, Mississippi 39201

WATER WELL DRILLERS LOG

Bolivar  
N 65  
11-67

11/21 1967 Bailey Drilling Co Bolivar  
 date well completed firm name county well located

LANDOWNER: W. L. Burroughs  
Benoit, Miss.

description of formations encountered	depth	
	from	to
Clay	0	38
Sand	38	50
Gravel	50	114
Rock	114	116
Gravel	116	120
Mud	120	360
Rock	360	361
Sand	361	375
Mud	375	385
Sand	385	472

(mailing address)

WELL LOCATION:

sec 4 T 21 N R 8 W  
2 miles W of Benoit  
 (distance) (direction) (nearest town)

WELL PURPOSE: Home  
 (home, irrigation, municipal, industrial)

WELL COMPLETION DATA:

(1) diameter (inches) 2 1/2 x 2  
 (2) total depth (feet) 472  
 (3) static water level (feet) 41 below above top of ground.

CODED

(4) casing Steel  
 (material) (depth)  
2 1/2 x 2 if telescope see back.  
 (size)


(5) screen 10' 462  
 (length) (depth to top)  
2" Stainless Steel  
 (size) (material)

(6) pump 1 10  
 (HP) (yield gpm)  
Elec  
 (type power)

(7) electric log No  
 (yes or no)

(organization running log)

(8) how well bottom plugged  
Back pressure valve

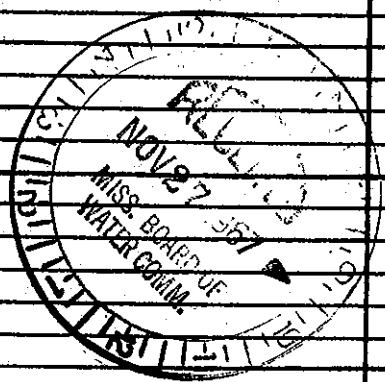

DRILLERS REMARKS: