

CODED

CODED

Bolivar
N 66
2-68

MISSISSIPPI
 BOARD OF WATER COMMISSIONERS
 416 North State Street
 Jackson, Mississippi 39201

2/24/68
 C 2594

WATER WELL DRILLERS LOG

February 12, 19 68 Layne-Central Company Bolivar
 date well completed firm name county well located

LANDOWNER: Delta & Pine Land Co. Lee=Headquarters	description of formations encountered	from	to
Scott, Mississippi (mailing address)	Clay	0	14
	Fine sand	14	60
	Coarse sand	60	100
	Coarse sand, gravel	100	114
	Hard pink clay	114	289
	Sandy shale with hard strks	289	342
	Fine white sand	342	388
	Coarse sand	388	414
	Hard clay	414	487
	White pack sand	487	525
	Shale	525	526
	Coarse white sand	526	556
	Shale	556	562


WELL LOCATION:
 sec. 7 T. 21 N. R. 9 E. S. 1 W. Scott
 (distance) (direction) (nearest town)

WELL PURPOSE: home
 (home, irrigation, municipal, industrial)

WELL COMPLETION DATA:

- (1) diameter (inches) 4"
- (2) total depth (feet) 562' 7"
- (3) static water level (feet) 39' 7" below top of ground.
- (4) casing steel, 525' (material) (depth)
 4" (size) If telescope see back.
- (5) screen 30' 7" (length), 555' 7" (depth to top)
 4" (size), Stainless Steel (material)
- (6) pump 3 (HP), 50 (yield gpm), electric (type power), 7' B.P.V.
- (7) electric log no (yes or no)
 (organization running log)
- (8) how well bottom plugged - shot

CODED

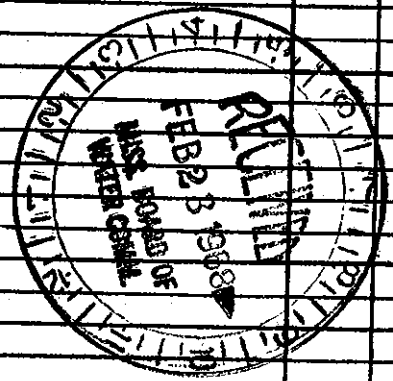

DRILLERS REMARKS: