

Boyle-Skene Water Corporation

Well No. 4


(City) Benoit

(County) Bolivar

State MS

Location of Well Under New Water Tower

Made in Test Hole No.

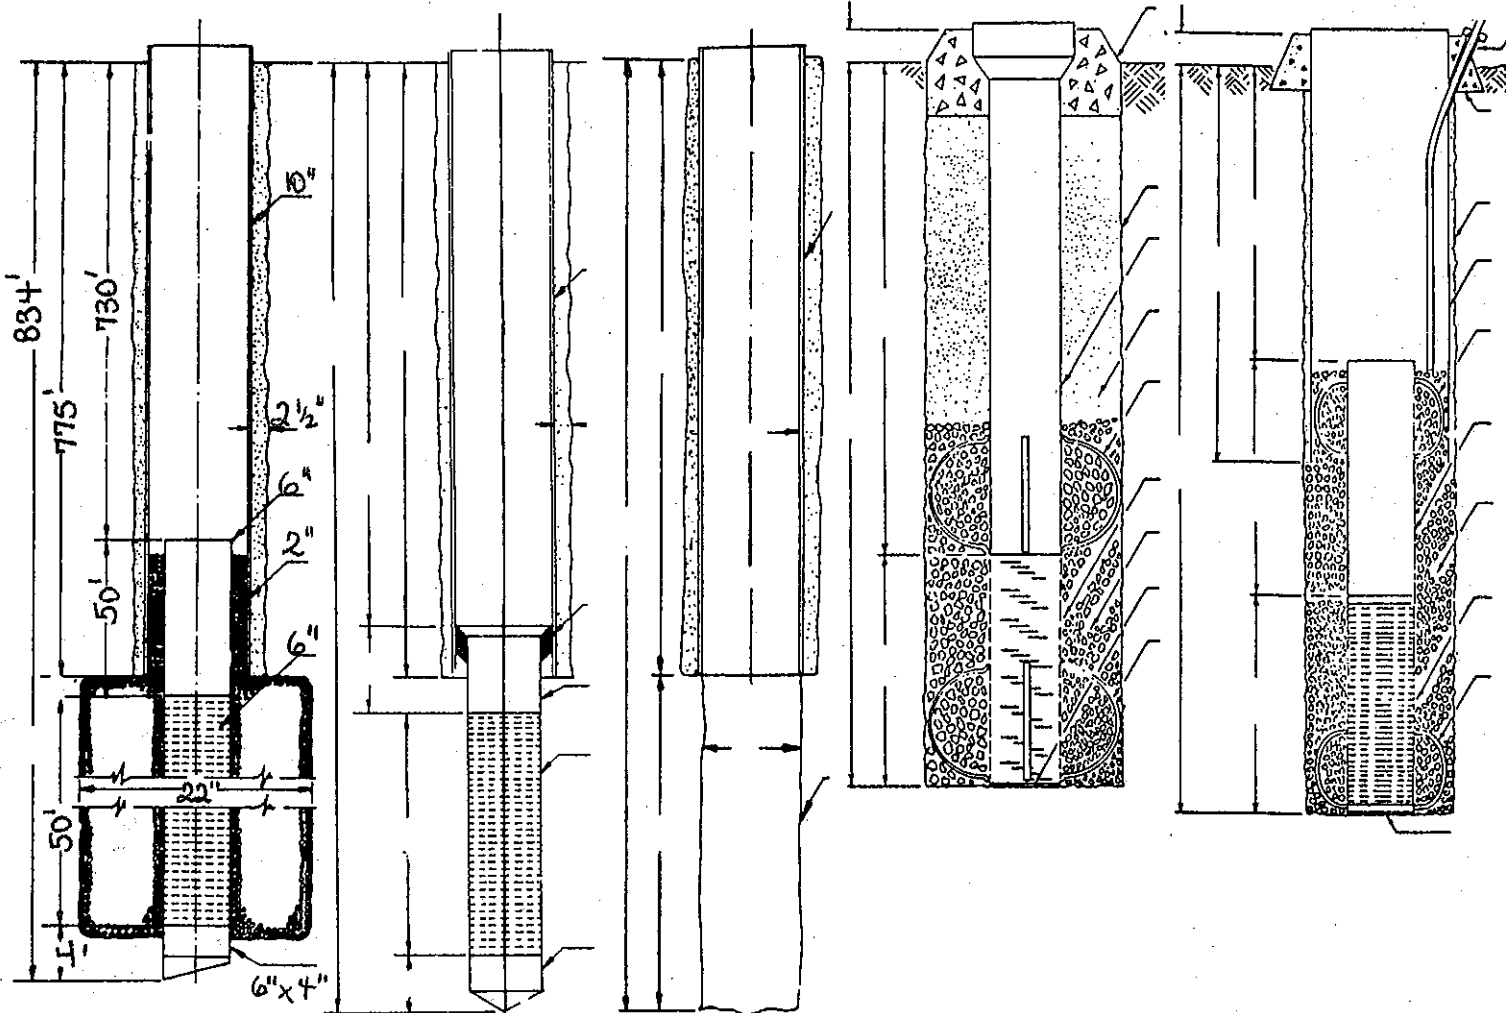

CONTRACT NO. 228623

STARTED WELL 9/23/01 19 AND COMPLETED 11/01/01 19

TOTAL DEPTH 834' ELEVATION STATIC WATER LEVEL 57'

ALL MEASUREMENTS TAKEN FROM (GROUND) (TOP OF FOUNDATION) (TOP OF CASING) (TOP BASE PLATE)

SURFACE CASING; SIZE 16" LENGTH 38' THICKNESS .375

CEMENTED WITH 45 SACKS CEMENT OR PACKER TYPE

WELL CASING; SIZE 10" LENGTH 775' WEIGHT

CEMENTED WITH 500 SACKS CEMENT Halliburton OR PACKER TYPE

INNER CASING SIZE 6" LENGTH 50' TYPE MATERIAL SST

WITH 1 1/2" x 3" (GUIDES LOCATED) 4' top, 8' bottom TYPE BACKOFF Lefthand

SIZE SEAL BACKPRESSURE VALVE SIZE 6" x 4" LENGTH GUIDE 4'

WELL STRAINER: MAKE Houston TYPE wire SIZE 6" LENGTH 50' OPENING .020

TYPE MATERIAL stainless WITH welded CONNECTIONS

SIZE HOLE DRILLED FOR SURFACE CASING 19" WITH wing

SIZE HOLE DRILLED FOR WELL CASING 15" WITH hole opener

SIZE HOLE DRILLED FOR STRAINER 22" WITH grant under REA

YARDS OF GRAVEL USED 6.6 sks HOW PLACED tremmie pipe TYPE 10/20

HOW WAS WELL DEVELOPED air agitator SAND? no CLEAR? yes

FOUNDATION INSTALLED YES LINE DEPTH FEELING RODS TOP OF WELL

NOTES:

RIG USED 2250 SUPT. Buddy Lowery DRILLER Henry Butler



RECEIVED

FEB 06 2006

BY: OLWR

LAYNE CENTRAL DIVISION

LW-177 7/90

Boyle-Skene Water Association

Benoit, MS

DATE 11/01/01

OF SEC. _____ TS _____ R _____

COUNTY Bolivar

TOTAL DEPTH	EACH STRATUM	FORMATION	TOTAL DEPTH	EACH STRATUM	FORMATION
0-13	13	Sandy Clay			
13-65	52	Clay			
65-123	58	Clay - Gravel			
123-153	30	Clay, Sand Streaks			
153-158	5	Rock			
158-190	32	Clay			
190-314	124	Sand, Shale			
314-340	26	Coarse Sand			
340-460	120	Coarse Sand, Clay Streaks			
460-531	71	Clay, Sand Streaks			
531-597	66	Sandy Shale			
597-610	13	Clay			
610-648	38	Coarse Sand, Shale			
648-730	82	Sand, Lignite, Clay			
730-760	30	Sand Lignite			
760-851	91	Sand			
851-866	15	Sand and Clay Streaks			

RECEIVED
FEB 06 2006
BY: OLWR

DRILLING TIME _____
DAYS ON JOB XX
SIZE TEST HOLE 12-1/4
TYPE BIT USED Roller

Henry Butler

DRILLER

Buddy Lowery

FIELD SUPT.

