

Bolivar

GAYLON LAWRENCE

State Well Report

Part 1

Mississippi Department of Environmental Quality
Office of Land and Water Resources
P.O. Box 10631
Jackson, MS 39289-0631
(601)961-5210
(601)354-6938 (fax)

For Office Use Only:

Aquifer: _____
Well #: N-121
L. S. Elevation: _____
E-log #: _____

County: WASHINGTON
Permit #: OW 41263
Driller: JOHN NEWCOMB
Date drilling completed: 7-15-06

State Law requires that this report be prepared by the driller in detail and filed with the Department within 30 days of completion of drilling of the well.

Well Owner Information	Well Location
Owner Name: <u>GAYLON LAWRENCE</u>	Latitude: <u>33° 37' 29"</u> Longitude: <u>91° 03' 03"</u>
Mailing Address: <u>DELTA PINGLAND MGMT</u> <u>PO Box 5469</u> <u>GREENVILLE, MS. 38704</u>	Method of Lat/Long (circle one): Conventional Survey, USC, <u>Hand-held GPS</u> , Survey-grade GPS
City: _____ State: _____ Zip Code: _____	<u>NE</u> 1/4 <u>SW</u> 1/4 Sec <u>11</u> Twn <u>21N</u> Rng <u>8W</u> <u>SE</u> <u>NW</u>
Telephone No: <u>662-820-8686</u>	Distance: <u>2</u> Miles Direction: <u>NORTH</u> of Nearest Town: <u>SCOTT MS.</u>

Well Data

Purpose of Well (circle one) Home Industrial Public Supply Irrigation Fish Culture Other: Replace Well

Date well drilling started: 7-15-06 Date well drilling completed: 7-15-06 GW10264

If flowing, method of flow regulation: Valve _____ Other (describe) _____

Static Water Level: 18 feet above or below (circle one) land surface Date measured: 7-15-06

Method of Measurement (circle one) steel tape electric tape air line other: _____

Hole depth: 113 Well depth: 110 Well grouted to a depth of 10 feet

Type of grout (circle one): Cement Bentonite Mix

Casing length: 85 feet Casing diameter: 16 inches Type of casing: PVC

Screen length: 25 feet Screen diameter: 16 inches Type of screen: PVC

Screen slot size: 050 inches Setting depth: From 75-85 feet to 95-110 feet

Type of completion (circle all applicable): Gravel packed Underreamed Telescoped Open hole Natural Development
Other (describe): _____

Top of lap pipe or reduction in casing: _____ feet. If telescoped or more than one screen, describe on back of page

Logs run (circle all applicable): No log run Electric Gamma Ray Density Sonic Neutron Other: _____

Name of organization running log(s): _____

I certify that the well was drilled, constructed, and completed in accordance with all applicable requirements of the Mississippi Department of Environmental Quality and/or the Mississippi Department of Health regulations and state laws.

JOHN NEWCOMB 0-773
Print Name of Water Well Contractor and License No.

[Signature]
Signature of Water Well Contractor


Replacement for GW10264

RECEIVED
AUG 15 2006
BY: OLWR

N-

If well telescopes please sketch below and show depths.


Ground Level

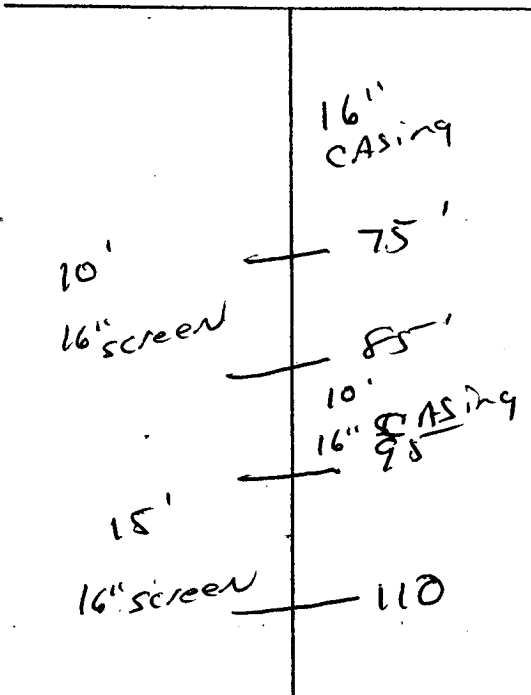

Description of Formations Encountered	From	To
Top Soil	0	10
Mix CLAY	10	38
Blue mud	38	75
COARSE sand	75	85
Fine Sand	85	95
COARSE SAND	95	110
Gray CLAY	110	113

If more than one screen, show location of each on sketch

Sketch the property layout and include the following: 1) the well location; 2) any permanent structures on the property that may aid in locating the well; 3) any roads, power lines, or other items that may aid in locating the property and the well; 4) indicate direction.

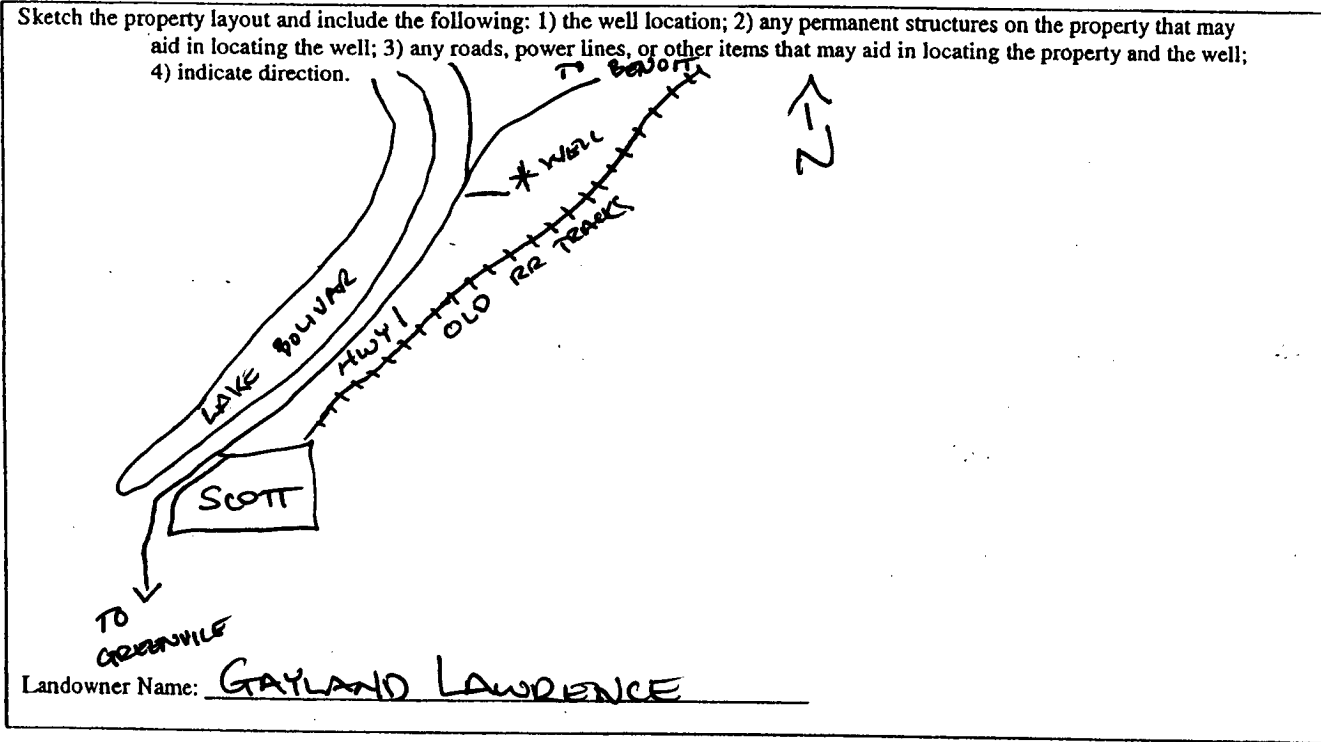

Gayland Lawrence
Signature of Water Well Contractor

STATE WELL REPORT

Part 2

Pump Installer's Completion Report
 Mississippi Department of Environmental Quality
 Office of Land and Water Resources
 P.O. Box 10631
 Jackson, MS 39289-0631
 (601)961-5210
 (601)354-6938 (fax)

For Office Use Only:

Aquifer: _____

Well #: N-121

Elevation: _____

County: ~~WASHINGTON~~
 Permit # GW 41263
 Driller: JOHN NEWCOMB # 773
 Date completed: 7-15-06

This report should be prepared by the pump installer in detail and filed with the Department within 30 days of the installation of pump.

Well Owner Information	Well Location
Owner Name: <u>GAYLON LAWRENCE</u>	Latitude: <u>33-37-29</u> Longitude: <u>091-03-03</u>
Mailing Address: <u>DELTA PINE LAND MGMT</u> <u>PO BOX 5669</u> <u>GREENVILLE MS 38704</u>	Method of Lat/Long (circle one): Conventional Survey, USGS quad, <u>Hand-held GPS</u> , Survey-grade GPS
City: _____ State: _____ Zip Code: _____	<u>NE</u> 1/4 <u>SW</u> 1/4 Sec <u>11</u> Twp <u>21N</u> Rng <u>8W</u>
Telephone No: <u>662-820-8686</u>	Distance: <u>2</u> Miles <u>N</u> Direction of <u>SCOTT, MS.</u> Nearest Town

Pump Type Circle one	Power Type Circle one
Air Lift: Jet <input type="checkbox"/> Submersible <input type="checkbox"/>	<u>Diesel Engine</u> Gasoline Engine Natural Gas
Bucket: Piston <input type="checkbox"/> <u>Turbine</u> <input type="checkbox"/>	Electric Motor Hand Tractor PTO
Centrifugal: Rotary <input type="checkbox"/> Flowing Well <input type="checkbox"/>	Windmill Other (specify): _____
Other (specify): _____	Horse Power Rating of Motor: <u>40</u>
Date Pump Installed: <u>7-26-06</u>	Setting Depth: <u>60</u> feet
Rated Pump Capacity: <u>1200</u> Gallons Per Minute	Number of Stages: <u>2-10DH</u>

Pump Test Data	Method of Measuring Water Level Circle one
Date Well Tested: _____	Air Line Electric Measuring Line Steel Tape
Static Water Level (A): _____ Feet Below Land Surface	Other (specify): _____
Pumping Water Level (B): <u>NO TEST</u> Feet Below Land Surface	For flowing well, measured shut in head: _____ feet
Drawdown (B) - (A): _____ Feet Below Land Surface	Well yielded _____ GPM with a drawdown of _____ feet after _____ hours of pumping
Test Pumping Rate: _____ Gallons Per Minute	
Duration of Pump Test (minimum 4 hours): _____ hours	

I HEREBY CERTIFY that the above statements are true to the best of my knowledge.

GLEN TOWSE #710-9 Signature of Pump Installer

Print Name of Pump Installer and License No. (if applicable)

RECEIVED
 AUG 15 2006
 BY: OLWR

Handwritten text at the top right of the page.

Handwritten text in the upper middle section.

Handwritten text on the left side, top row.

Handwritten text on the right side, top row.

Handwritten text on the left side, middle row.

Handwritten text on the right side, middle row.

Handwritten text on the left side, bottom row.

Handwritten text on the right side, bottom row.

Handwritten text in the lower middle section.

Handwritten text in the lower middle section.

Handwritten text in the lower right section.

Large handwritten text at the bottom of the page.

Vertical handwritten text on the bottom left corner.