

BURRS #1

State Well Report

Part 1

Mississippi Department of Environmental Quality
Office of Land and Water Resources
P.O. Box 10631
Jackson, MS 39289-0631
(601)961-5210
(601)354-6938 (fax)

For Office Use Only:

Aquifer: N 149
Well #: _____
L. S. Elevation: _____
E-log #: _____

County: BOLIVAR
Permit #: GW-452031
Driller: J. NEWCOME 0773
Date drilling completed: 5-23-2011

State Law requires that this report be prepared by the driller in detail and filed with the Department within 30 days of completion of drilling of the well.

Well Owner Information	Well Location
Owner Name: <u>Winn Jr, Eustace H, Estate</u>	Latitude: <u>33.38.18</u> " Longitude: <u>91.00.09</u> "
Mailing Address: <u>1111 East Gwynn drive</u>	Method of Lat/Long (circle one): <u>Conventional Survey</u>
<u>Greenville</u> <u>MS</u> <u>38701</u>	USGS quad: <u>Hand-held GPS</u> Survey-grade GPS
City State Zip Code	<u>SW</u> 1/4 <u>SW</u> 1/4 Sec <u>28V</u> Twn <u>21N</u> Rng <u>03W</u>
Telephone No. () _____	NW Distance _____ Direction <u>SE</u> Nearest Town <u>BENDIT</u> Miles of

Well Data

Purpose of Well (circle one) Home Industrial Public Supply Irrigation Fish Culture Other: _____

Date well drilling started: 5-23-2011 Date well drilling completed: 5-23-2011

If flowing, method of flow regulation: Valve _____ Other (describe) _____

Static Water Level: _____ feet above or below (circle one) land surface Date measured: _____

Method of Measurement (circle one) steel tape electric tape air line other: _____

Hole depth: 112 Well depth: 110 Well grouted to a depth of 10 feet

Type of grout (circle one): Cement Bentonite Mix

Casing length: 70 feet Casing diameter: 16 inches Type of casing: P.V.C.

Screen length: 40 feet Screen diameter: 16 inches Type of screen: P.V.C.

Screen slot size: .050 inches Setting depth: From 70 feet to 110 feet

Type of completion (circle all applicable): Gravel packed Underreamed Telescoped Open hole Natural Development
Other (describe): _____

Top of lap pipe or reduction in casing: _____ feet. If telescoped or more than one screen, describe on back of page

Logs run (circle all applicable): No log run Electric Gamma Ray Density Sonic Neutron Other: _____

Name of organization running log(s): _____

I certify that the well was drilled, constructed, and completed in accordance with all applicable requirements of the Mississippi Department of Environmental Quality and/or the Mississippi Department of Health regulations and state laws.

JOHN NEWCOME 0-773
Print Name of Water Well Contractor and License No.


[Signature]
Signature of Water Well Contractor

RECEIVED
JUL 28 2011
BY [Signature]

N149

If well telescopes please sketch below and show depths.

Ground Level

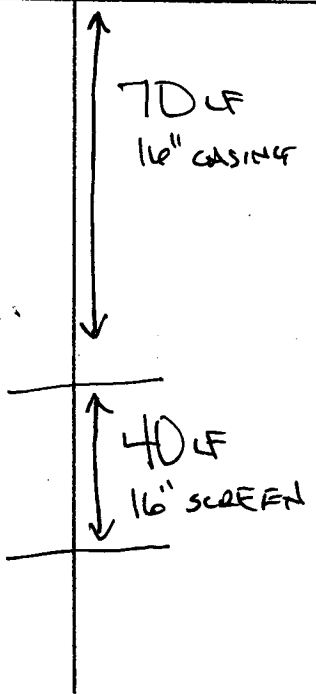

Description of Formations Encountered

From To

Description of Formations Encountered	From	To
TOP SOIL	0	10
FINE SAND/CLAY STRIPS	10	30
SAND	30	50
MED. / COARSE SAND	50	65
COARSE SAND / PEA GRAVEL	65	110
BOTTOM	110	112

If more than one screen, show location of each on sketch

Sketch the property layout and include the following: 1) the well location; 2) any permanent structures on the property that may aid in locating the well; 3) any roads, power lines, or other items that may aid in locating the property and the well; 4) indicate direction.

SEE MAP

Landowner Name: _____

Jol Newman
 Signature of Water Well Contractor

STATE WELL REPORT

Part 2

Pump Installer's Completion Report
 Mississippi Department of Environmental Quality
 Office of Land and Water Resources
 P.O. Box 2309
 Jackson, MS 39225
 (601)961-5210
 (601)961-5228 (fax)

County: Bolivar
 Permit #: GW-45203
 Driller: J. Newcome 0-773
 Date completed: 5.23.2011
Copy information from block on Part 1

For Office Use Only:

Aquifer: _____
 Well #: N1A9
 Elevation: _____

This part of the report must be completed by a licensed water well contractor or a licensed pump installer. A copy of Part 1 of the report must be attached and both parts filed with the Department at the above address within 30 days of well completion.

Well Owner Information	Well Location
Owner Name: <u>Winn Jr, Eustace H, Estate</u>	Latitude: <u>33° 38' 18"</u> Longitude: <u>91° 00' 09"</u>
Mailing Address: <u>1111 East Gamwyn Dr.</u>	Method of Lat/Long (check one): Conventional Survey _____
<u>Greenville MS 38701</u> City State Zip Code	USGS quad _____, Hand-held GPS <input checked="" type="checkbox"/> , Survey-grade GPS _____
Telephone No. (____) _____	<u>GW</u> ¼ <u>SW</u> ¼ Sec <u>28</u> T <u>21</u> R <u>08</u>
	Distance _____ Direction _____ Nearest Town _____ <u>1</u> Miles <u>SE</u> of <u>Benoit</u>

Pump Type	Power Type
Circle one	Circle one
Air Lift <input type="checkbox"/> Jet <input type="checkbox"/> Submersible <input type="checkbox"/>	<input checked="" type="checkbox"/> Diesel Engine <input type="checkbox"/> Gasoline Engine <input type="checkbox"/> Natural Gas
Bucket <input type="checkbox"/> Piston <input type="checkbox"/> <input checked="" type="checkbox"/> Turbine <input type="checkbox"/>	Electric Motor <input type="checkbox"/> Hand <input type="checkbox"/> Tractor PTO
Centrifugal <input type="checkbox"/> Rotary <input type="checkbox"/> Flowing Well <input type="checkbox"/>	Windmill <input type="checkbox"/> Other (specify): _____
Other (specify): _____	Horse Power Rating of Motor: <u>60</u>
Date Pump Installed: <u>5/24/11</u>	Setting Depth: <u>70</u> feet
Rated Pump Capacity: <u>2800</u> Gallons Per Minute	Number of Stages: <u>1</u>

RECEIVED
 JUL 08 2011
 BY: OLWR

Pump Test Data	Method of Measuring Water Level
	Circle one
Date Well Tested: _____	Air Line <input type="checkbox"/> Electric Measuring Line <input type="checkbox"/> Steel Tape <input type="checkbox"/>
Static Water Level (A): _____ Feet Below Land Surface	Other (specify): _____
Pumping Water Level (B): _____ Feet Below Land Surface	For flowing well, measured shut in head: _____ feet
Drawdown [(B) - (A)]: _____ Feet Below Land Surface	Well yielded _____ GPM with a drawdown of _____ feet after _____ hours of pumping
Test Pumping Rate: _____ Gallons Per Minute	
Duration of Pump Test (minimum 4 hours): _____ hours	

This is for (circle one): New Well Replacement of Existing Pump Repair of Existing Pump

I HEREBY CERTIFY that the above statements are true to the best of my knowledge.

Cory Rowe 0-711P _____
 Print Name of Pump Installer and License No. (if applicable) Signature of Pump Installer




MARIS
Online Maps

Internet Mapping Framework



This map is a user generated static output from an Internet mapping site and is for general reference only. Data layers that appear on this map may or may not be accurate, current, or otherwise reliable. THIS MAP IS NOT TO BE USED FOR NAVIGATION.

Map center: 384344, 1426716

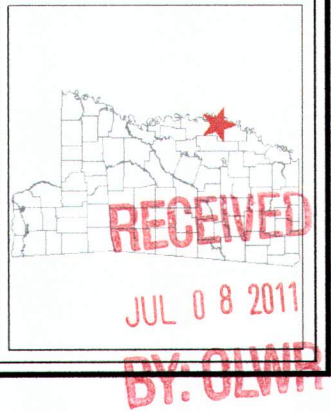

Legend

- County Boundaries
- MS One Call Natchez Trace Parkway
- MS One Call Interstate Highway
- MS One Call US / State Highway
- MS One Call 3 digit State Highway
- MS One Call County Roads and Streets
- Incorporated Cities
- Other Urban (non-incorporated)
- NHD Other Areas (dri streams and inun)
- adama07_m.sid
- alcorn07_m.sid
- amite07_m.sid
- attala07_m.sid
- benton07
- bolivar07_m.sid
- calhoun07_m.sid
- carroll07_m.sid
- chickasaw07_m.sid
- choctaw07_m.sid
- clarborne07_m.sid
- clarke07_m.sid
- clay07_m.sid
- coahoma07_m.sid



Scale: 1:22,208

