PAHOMEY

, *., ł

	STATE V	WELL REPORT					
County: BOLIVAR	Part 1		For Office Use Only:				
Permit #: GW - 46985	Driller's Log		Well #:63				
Driller: J.NEWCOME 0.773	Mississippi Department of Environmental Quality Office of Land and Water Resources		Aquifer:				
Date drilling completed: 6.18.13		.0. Box 2309	E-Log #:				
		on, MS 39225-2309 601)961-5210					
(601)360-0535 (fax)							
State Law requires that this report be prepared by the license holder responsible for the work and filed with the Department at the above address within 30 days of completion of drilling of the well or borehole.							
Well Owner Informat (Landowner if borehole is not for	ion a water well)	Well or Bore Latitude: <u>33° 40`5기''</u> Lor	whole Location $(\mathcal{O})^{*} \mathcal{O}^{*} \mathcal{O}^{*} \mathcal{O}^{*}$				
Owner Name: GEORGE ABBOTT	-		-				
Mailing Address: 2666 CLERMON	T PLACE		y): Conventional Survey,				
		USGS quad, Hand-held G	$PS X, Survey-grade GPS $ $0.2 \sqrt{T} 21 N R 08 W$				
CULLERVILLE TN City State	38017	$\frac{1}{1}$ $\frac{1}$	02V T 21Nº R 08W				
City State	Zip Code	<u>2</u> _{Miles} N o	F_BENOIT				
Telephone No. ()		(Distance) (Direction)	(Nearest Town)				
	Well / B	orehole Data	<u> </u>				
Date drilling started: $6.18.13$ Date drilling completed: $6.18.13$ Hole depth: 122 Hole diameter: $24''$							
Location of the source of any surface water used for drilling:							
Method of dosing and volume of Chlori	ne used in drilling a	nd development: CHLORIA	DE PABLATS				
Logs run (circle all applicable): No log run Electric Gamma Ray Density Sonic Neutron Other:							
Name of organization running log(s):							
Purpose of borehole (circle one): Water Well Geotechnical/Geological Investigation Ground Source Heat Pump							
Seismic Survey Other (<i>describe</i>)							
If drilling is not related to water well construction, skip the remainder of this block							
Purpose of Well (circle all applicable): Home Industrial Public Supply Irrigation Fish Culture							
Other (describe):							
If a flowing well, method of flow regulation: Valve Other (<i>describe</i>)							
Static Water Level:feet [above or below] land surface Date measured:feet [above or below] land surface Date measured:							
Method of measurement (circle one): Steel tape Electric tape Air line Other (describe):							
			210				
Casing length: reet Casing diameter: incres Type of casing							
Screen length: <u>40</u> feet Screen diameter: <u>16</u> inches Type of screen: <u>P.V.S.</u> Screen slot size: B ,050 inches Setting denth: From B 0 feet to 120 feet							
Type of completion (<i>circle all applicable</i>): Gravel packed Underreamed Open hole Natural Development							
Other (describe):							
Top of lap pipe or reduction in casing:feet							
If telescoped or more than one screen, describe on next page							


Form: OLWR-SWR-1A (4/13)

County: Baliva		For Office Use (Only:
Permit #: <u>66446985</u>		Well #:	
The sketch below only required for water wells	Description of formations encountered must be provided for all wells and boreholes, unless specifically exempted by regulations		
If well telescopes, show depths on sketch.	Description of Formations Encour	ntered From (death)	
Ground Level	TOP SOIL	ntered From (depth) Ground level	To (depth)
\uparrow	CLAY	10	25
	SAND	25	55
	MGD. COARJE	55	60
$ \langle \langle \rangle \rangle_{LF}$	CORESE SAND PUBBLI	ESTRIP BO	120
	BOTTOM	120	122
16" CASING			
V			
$ \uparrow$			
$ 4() _{\rm F}$			
16"Sceen			
1 le Schart			
If more than one screen, show location of each on sketch			
 Sketch the property layout and include the following: 1) the well location 2) any permanent structures on the property that may aid i 3) any roads, power lines, or other items that may aid in lo 4) north arrow 	in locating the well cating the property and the well		
Set	Mar		
			1
Landowner Name:			
I HEREBY CERTIFY that the well/borehole was drilled, con requirements of the Mississippi Department of Environmer if applicable, and state laws.	structed, and completed in acc ntal Quality and the Mississippi I	cordance with all applicabl Department of Health regu	e Ilations,
JOHN NEWCOME O.M.S. 6	18.203 (1)		
Print Name of Responsible Licensee and License No.		ignature of Licensee	

Signature of Licensee Form: OLWR-SWR-1A (4/13)

Ţ

2 5 x 8

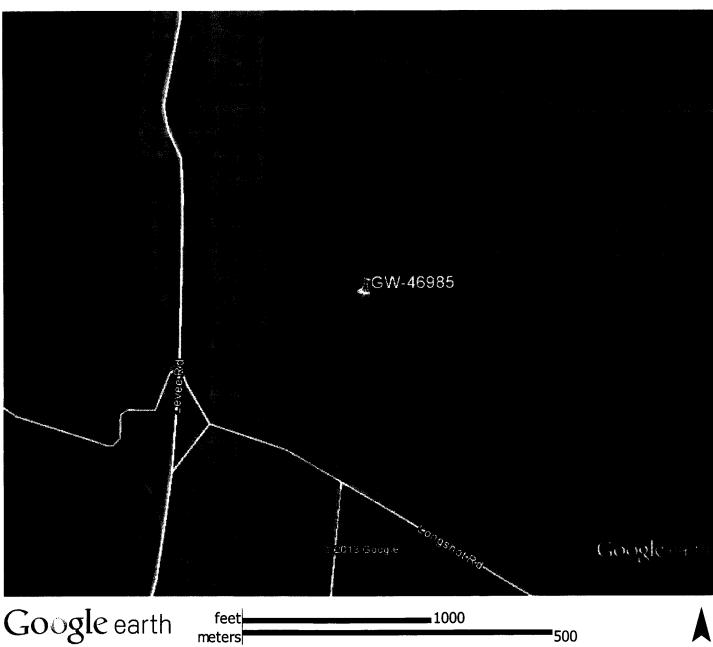

• ۲,

BREAKED

500

STATE WELL REPORT						
County: Bolivar Part 2		For Office Use Only:				
Permit #: (SLA) - 4/6 985 Pump Installe	er's Completion Report					
Mississippi Departr	nent of Environmental Quality nd and Water Resources	Well #:				
Date completed: (0-18-13)	.O. Box 2309	Aquifer:				
Jackso	on, MS 39225-2309 601)961-5210	Aquiler.				
) 360-0535 (fax)					
This part of the report must be completed by a licensed water well contractor or a licensed pump installer. A copy of Part 1 of the report must be attached and both parts filed with the Department at the above address within 30 days of well completion.						
Well Owner Information		ocation				
	Latitude: <u>33 40 · 57</u> on	gitude: <u>91 01 21</u>				
Mailing Address: 2666 (lermont Place						
	USGS quad, Hand-held GPS_X, Survey-grade GPS					
Collierville TN/ 38017 City State Zip Code	IR 1/ IR 14, Sec O2 T2/NR OSW					
	2 Miles N of Benoit					
Telephone No. ()	(Distance) (Direction)	(Nearest Town)				
Pump Ty	pe (circle one)					
Submersible Turbine Air Lift Centrifugal Flowing Well	Jet Piston Rotary Other (de	scribe):				
Date Pump Installed:						
Is This Pump (circle one): (New) Repaired Replaceme						
	pe (c ircle one)					
Electric Diesel Gasoline Natural Gas Tractor PTO Win	~ 7					
Horse Power Rating of Motor: Setting Dept	th: <u>10</u> feet Number	of Stages:				
Pump Test Data	for Non Flowing Well					
	Duration of Dump Tost (minim	um 4 hours): hours				
Static Water Level (A: Feet Below Land Surface Pumping Water Level (B): Feet Below Land Surface						
Drawdown [(B) - (A)]: Feet Below Land Surface Test Pumping Rate: Gallons Per Minute						
		t i i i i i i i i i i i i i i i i i i i				
Method of measurement (circle one): Steel tape Electric ta Pump Test Da	ta for Flowing Well					
Measured shut in head:feef						
$ U \cup E = V $						
Well yielded GPM with a drawdown of	feet_after	hours of pumping				
Meter Installation						
Meter Manufacturer:	Aeter Serial Number:	Front Server 1 - 1 - 1 - 1 - 1 - 1 - 1 - 1 - 1 - 1				
Meter Model Number/Namer						
Totalizer Register Unit and Multiplier Factor (AF x .001, gal x 1000, etc):						
Installation Date: Meter installed by:						
Is This Meter (<i>circle one</i>): New Repaired Replacement						
Important: By submitting the above information you are certifying that this meter was installed to manufacturer standards. For agricultural wells, a list of approved meters is on the MDEQ website.						
I HEREBY CERTIFY that the above statements are true to the best of my knowledge.						
Hubbard Stephens 741-P 7-20-13 Hubbard						
Print Name of Pump Installer and License No. (<i>if applicable</i>) Date Signature of Pump Installer						
		Earm: OI \A/D_\$\A/D_7A (4/12)				

¥ 142, ₽