

Bolivar

MISSISSIPPI BOARD OF WATER COMMISSIONERS

N-1002
260


WATER WELL DRILLERS LOG

1/21/66
C 805

Date: Feb. 4, 1960, Driller: Layne-Central Company County Bolivar

(Name)

(1) Owner of Land: <u>Allen Gray Estate</u> (Name)	Description & Color of Materials Sand, Clay, Red Clay, Shell, etc.	Thick- ness Feet	Depth Feet
<u>Benoit, Mississippi</u> (Address)	Clay	13	13
(2) Location: <u>1/4</u> , <u>1/4</u> , Sec. <u>T</u> <u>R</u>	Fine sand	8	21
<u>12</u> miles <u>west</u> , of <u>Boyle</u> (distance) (direction) (Nearest Town)	Blue clay	26	47
(3) Topography: <u>flat</u> (Hilly) (Flat) (Level)	Blue gummy clay	8	55
(4) Purpose of Well: <u>irrigation</u> (Domestic Irrigation Municipal, Industrial, Other)	Coarse sand	20	75
Information upon completion of well:	Pea gravel & sand	35	110
(1) Diameter <u>16</u> inches.	Big rocks	2	112
(2) Total Depth <u>112</u> feet.			
(3) Water Level <u>17' 2"</u> feet below top of ground.			
(4) Cased to <u>62'</u> , Size <u>16"</u>			
(5) Screen: Size <u>16"</u> , Length <u>50'</u>			
(6) Were any formations sealed against pollution? <u>no</u> yes, <u>no</u> no.			
If YES depth of formation _____			
Why _____			
Drillers Remarks: <u>2500 GPM.</u>			
<u>Electric power.</u>			

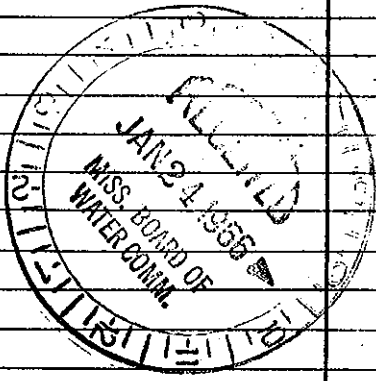

Well No.

(Use Back Side)

Mail this copy to Board of Water Commissioners 429 Miss. St. Jackson, Miss