

Bolivar  
N-1004  
3-66


MISSISSIPPI BOARD OF WATER COMMISSIONERS

WATER WELL DRILLERS LOG

4/1/66  
210

Date: March 24, 1966, Driller: Layne-Central Company County Bolivar  
(Name)

(1) Owner of land: <u>Allen Gray Estate</u> (Name)	Description & Color of Materials Sand, Clay, Red Clay, Shell, etc.	Thick- ness Feet	Depth Feet
<u>Benoit, Mississippi</u> (Address)	Fine black sand	16	16
(2) Location: <u>1/4, 1/4, Sec. T R</u>	Clay	6	22
<u>_____</u> miles <u>_____</u> of <u>Benoit</u> (distance) (direction) (Nearest Town)	Clay & little sand	13	35
(3) Topography: <u>flat</u> (Hilly) (Flat) (Level)	Fine sand	7	42
(4) Purpose of Well: <u>irrigation</u> (Domestic Irrigation Municipal, Industrial, Other)	Little coarser sand	4	46
Information upon completion of well:	Coarse sand, pea gravel	6	52
(1) Diameter <u>16</u> inches.	Coarse sand, little clay	4	56
(2) Total Depth <u>122</u> feet.	Coarse sand, pea gravel	66	122
(3) Water Level <u>17</u> feet below top of ground.			
(4) Cased to <u>62'</u> , Size <u>16"</u>			
(5) Screen: Size <u>16"</u> , Length <u>60'</u>			
(6) Were any formations sealed against pollution? <u>_____</u> yes, <u>no</u> no.			
If YES depth of formation _____			
Why _____			
Drillers Remarks: _____			
_____			
_____			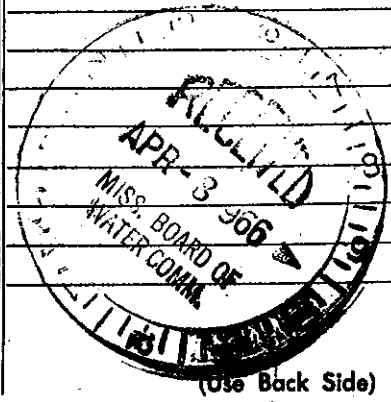
Well No.

(Use Back Side)

Mail this copy to Board of Water Commissioners 429 Miss. St. Jackson, Miss.