


**BOLIVAR MISSISSIPPI BOARD OF WATER COMMISSIONERS**

N 2000  
4-18-61

**WATER WELL DRILLERS LOG**

Date: 4-18, 1961, Driller DAVID F. BERRY & SON County YA 200  
(Name)

| (1) Owner of Land:  | Description & Color of Materials<br>Sand, Clay, Red Clay, Shell, etc. | Thick-<br>ness<br>Feet | Depth<br>Feet |
|---|---|------------------------|---------------|
| <u>C. B. WILLIAMS</u><br>(Name)   | <u>Gravel</u>   | <u>30</u>              | <u>30</u>     |
| <u>BeNOIT, MISS</u><br>(Address)  | <u>Sand</u>   | <u>20</u>              | <u>50</u>     |
| (2) Location: <u>1/4</u> , <u>1/4</u> , Sec. <u>   </u> T. <u>   </u> R. <u>   </u>   | <u>Sand</u>   | <u>20</u>              | <u>70</u>     |
| <u>   </u> miles <u>   </u> of <u>   </u><br>(distance) (direction) (Nearest Town)    | <u>Gravel</u>   | <u>21</u>              | <u>91</u>     |
| (3) Topography: <u>FLAT</u><br>(Hilly) (Flat) (Level)                                 | <u>Gravel</u>   | <u>20</u>              | <u>111</u>    |
| (4) Purpose of Well: <u>   </u><br>(Domestic Irrigation Municipal, Industrial, Other) | <u>Gravel</u>   | <u>20</u>              | <u>131</u>    |
| Information upon completion of well:  | <u>(Bottom) out of gravel 135'</u>                                    |                        |               |
| (1) Diameter <u>   </u> inches.   | <u>Shale - sand</u>   | <u>20</u>              | <u>152</u>    |
| (2) Total Depth <u>442</u> feet.  | <u>Shale</u>  | <u>22.3</u>            | <u>174.3</u>  |
| (3) Water Level <u>   </u> feet below top of ground.                                  | <u>Sand broken</u>  | <u>21.1</u>            | <u>195.4</u>  |
| (4) Cased to <u>   </u> , Size <u>   </u> .   | <u>Sand fine</u>  | <u>21.9</u>            | <u>217.3</u>  |
| (5) Screen: Size <u>   </u> , Length <u>   </u> .                                     | <u>Sand good drop</u>   | <u>21.4</u>            | <u>232.7</u>  |
| (6) Were any formations sealed against pollution?<br><u>   </u> yes, <u>   </u> no.   | <u>rockfield</u>  | <u>21.4</u>            | <u>254.1</u>  |
| If YES depth of formation <u>   </u>  | <u>7' sand - 10" neck - 1' sand</u>                                   |                        |               |
| Why <u>   </u>  | <u>6" neck - met shale</u>  | <u>21</u>              | <u>275.1</u>  |
| Drillers Remarks: <u>   </u>  | <u>Shale 10' sand</u>   | <u>20.8</u>            | <u>295.9</u>  |
| <u>   </u>  | <u>Sand - broken</u>  | <u>20.0</u>            | <u>315.9</u>  |
| <u>   </u>  | <u>Shale - brown</u>  | <u>22.1</u>            | <u>338.0</u>  |
| <u>   </u>  | <u>Shale - brown</u>  | <u>22</u>              | <u>360</u>    |
| <u>   </u>  | <u>Sand topping fine</u>  | <u>21</u>              | <u>381</u>    |
| <u>   </u>  | <u>Sand &amp; shale</u>   | <u>20</u>              | <u>402</u>    |
| <u>   </u>  | <u>Sand - fine</u>  | <u>20</u>              | <u>422</u>    |
| <u>   </u>  | <u>Sand - good</u>  | <u>20</u>              | <u>242</u>    |
| <u>   </u>  | <u>Sand</u>   | <u>21</u>              | <u>263</u>    |
| <u>   </u>  | <u>(Bottom) out at 462'</u>   |                        |               |
| <u>   </u>  | <u>1' shale</u>   |                        |               |
| <u>   </u>  | <u>Set at 442'</u>  |                        |               |

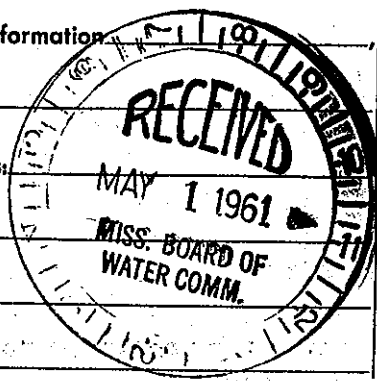

(Use Back Side)

Well No.

Mail this copy to Board of Water Commissioners 429 Miss. St. Jackson, Miss.