

BOLIVAR

MISSISSIPPI BOARD OF WATER COMMISSIONERS

N 2001

N

3-19-62

WATER WELL DRILLERS LOG

Date: 3/19, 1962, Driller: Bailey Drilling Co. County: Bolivar, Mississippi

(Name)

(1) Owner of Land: R K Shepherd Jr

(Name)

Benoit, Miss.

(Address)

Description & Color of Materials
Sand, Clay, Red Clay, Shell, etc.

Thick-
ness
Feet

Depth
Feet

Clay	18	18
Sand	17	35
Sand & Gravel	98	133
Mud	277	410
Sand & Mud	10	420
Sand	63	483

(2) Location: 1/4, 1/4, Sec. T. R.

1 miles W of Benoit
(distance) (direction) (Nearest Town)

(3) Topography: Flat

(Hilly) (Flat) (Level)

(4) Purpose of Well: Domestic

(Domestic Irrigation
Municipal, Industrial, Other)

6" rock at 135'
12" " at 250'


Information upon completion of well:

- (1) Diameter 2 inches.
- (2) Total Depth 483 feet.
- (3) Water Level 25 feet below top of ground.
- (4) Cased to all way, size 2
- (5) Screen: Size 2, Length 10 ft
- (6) Were any formations sealed against pollution?
yes, X no.

If YES depth of formation

Why

Drillers Remarks:

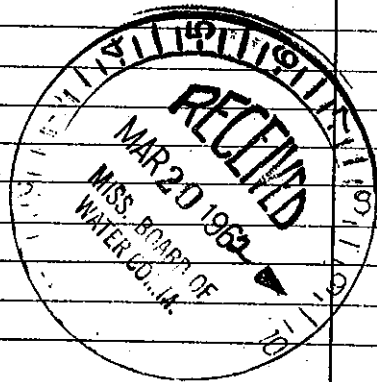

(Use Back Side)

Well No.

Mail this copy to Board of Water Commissioners 429 Miss. St. Jackson, Miss