

**BOLIVAR MISSISSIPPI BOARD OF WATER COMMISSIONERS**

N 2002  
3-5-65

**WATER WELL DRILLERS LOG**


Date: 3/5, 1965, Driller: Bailey Drlg. Co. County: Washington  
(Name)

(1) Owner of Land	Description & Color of Materials Sand, Clay, Red Clay, Shell, etc.	Thick- ness Feet	Depth Feet
<u>Dehoney Plantation</u> (Name) <u>Benoit, Miss.</u> (Address)	<u>Clay</u> <u>Sand</u>		<u>50</u> <u>100</u>
(2) Location: <u>1/4</u> , <u>1/4</u> , Sec. <u>T</u> <u>R</u>			
<u>4</u> miles <u>NW</u> of <u>Benoit</u> (distance) (direction) (Nearest Town)			
(3) Topography: <u>Flat</u> (Hilly) (Flat) (Level)			
(4) Purpose of Well: <u>domestic</u> (Domestic Irrigation Municipal, Industrial, Other)			

Information upon completion of well:

- (1) Diameter 4 X 2 1/2 inches.
- (2) Total Depth 100 feet.
- (3) Water Level 15 feet below top of ground.
- (4) Cased to all way Size 4 X 2 1/2
- (5) Screen: Size 2 1/2, Length 10 ft
- (6) Were any formations sealed against pollution?  
 yes,  no.

If YES depth of formation \_\_\_\_\_  
 Why \_\_\_\_\_  
 Drillers Remarks: \_\_\_\_\_

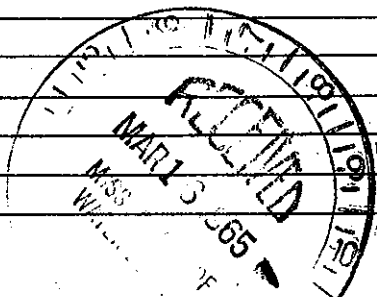

(Use Back Side)

Well No.

Mail this copy to Board of Water Commissioners 429 Miss. St. Jackson, Miss.