

BOLIVAR MISSISSIPPI BOARD OF WATER COMMISSIONERS

N 2003
2-20-65

WATER WELL DRILLERS LOG

Date: 2/20, 1965, Driller: Bailey Drlg Co. County Washington
(Name)

(1) Owner of Land:	Description & Color of Materials Sand, Clay, Red Clay, Shell, etc.	Thick- ness Feet	Depth Feet
<u>Dahomey Plantations</u> (Name)	<u>Clay</u>		<u>20</u>
<u>Benoit, Miss.</u> (Address)	<u>Sand</u>		<u>80</u>
(2) Location: <u>1/4</u> , <u>1/4</u> , Sec. <u> </u> T. <u> </u> R. <u> </u>	<u>Gravel</u>		<u>100</u>
<u>3</u> miles <u>N</u> of <u>Benoit</u> (distance) (direction) (Nearest Town)	<u>Mud</u>		<u>200</u>
(3) Topography: <u>Flat</u> (Hilly) (Flat) (Level)	<u>Mud + Sand</u>		<u>240</u>
(4) Purpose of Well: <u>Domestic</u> (Domestic Irrigation Municipal, Industrial, Other)	<u>Sand</u>		<u>260</u>
	<u>Mud</u>		<u>390</u>
	<u>Sand</u>		<u>405</u>
	<u>Mud</u>		<u>562</u>
	<u>Sand</u>		<u>610</u>


Information upon completion of well:

- (1) Diameter 4x3 inches.
- (2) Total Depth 610 feet.
- (3) Water Level 25 1/2 feet below top of ground.
- (4) Cased to all way, Size 4x3.
- (5) Screen: Size 3", Length 30'.
- (6) Were any formations sealed against pollution?
 yes, X no.

If YES depth of formation _____

Why _____

Drillers Remarks: _____

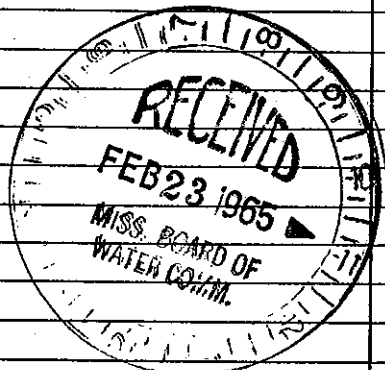

Well No.

(Use Back Side)

Mail this copy to Board of Water Commissioners 429 Miss. St. Jackson, Miss.