

BOLIVAR MISSISSIPPI BOARD OF WATER COMMISSIONERS

43
1-17-62

WATER WELL DRILLERS LOG

1/21/62 0-304
1209

Date: Jan. 17, 19 62, Driller: Layne-Central Company County Bolivar
(Name)

(1) Owner of Land: <u>Frank P. Unkel</u> (Name)	Description & Color of Materials Sand, Clay, Red Clay, Shell, etc.	Thick- ness Feet	Depth Feet
<u>Shaw, Mississippi</u> (Address)	<u>Clay</u>	<u>18</u>	<u>18</u>
(2) Location: <u>1/4</u> , <u>1/4</u> , Sec. <u>13</u> T <u>21N</u> R <u>7W</u>	<u>Fine sand</u>	<u>12</u>	<u>30</u>
<u>5</u> miles <u>west</u> of <u>Litton</u> (distance) (direction) (Nearest Town)	<u>Coarse sand</u>	<u>20</u>	<u>50</u>
(3) Topography: <u>flat</u> (Hilly) (Flat) (Level)	<u>Fine sand</u>	<u>7</u>	<u>57</u>
(4) Purpose of Well: <u>irrigation</u> (Domestic Irrigation Municipal, Industrial, Other)	<u>Coarse sand, gravel</u>	<u>21</u>	<u>78</u>
	<u>Coarse sand, gravel</u>	<u>22</u>	<u>100</u>
	<u>Big gravel</u>	<u>19</u>	<u>119</u>
	<u>Big rocks</u>	<u>11</u>	<u>130</u>
	<u>Blue clay</u>		<u>130</u>



Information upon completion of well:

- (1) Diameter 16 inches.
- (2) Total Depth 130 feet.
- (3) Water Level 15' - 7" feet below top of ground.
- (4) Cased to 60', Size 16"
- (5) Screen: Size 16", Length 70'
- (6) Were any formations sealed against pollution?
no yes, no no.

If YES depth of formation _____

Why _____

Drillers Remarks: _____

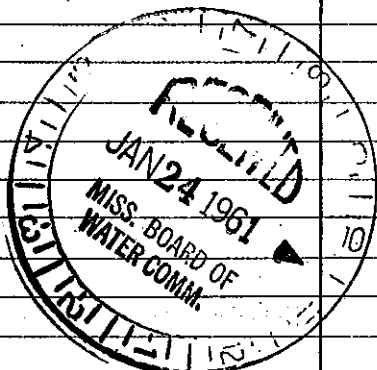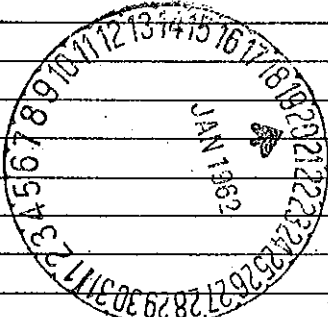

Well No.

(Use Back Side)

Mail this copy to Board of Water Commissioners 429 Miss. St. Jackson, Miss.