

BOLIVAR MISSISSIPPI BOARD OF WATER COMMISSIONERS

44
3-14-61

WATER WELL DRILLERS LOG

301
[Signature]

Date: March 14, 19 61, Driller: Layne-Central Company County Bolivar

(Name)

(1) Owner of Land: Verl Fullen
(Name)
Shaw, Mississippi
(Address) T21N
(2) Location: 1/4, 1/4, Sec. 23 R7W,
3 miles west, of Litton
(distance) (direction) (Nearest Town)
(3) Topography: flat
(Hilly) (Flat) (Level)
(4) Purpose of Well: domestic
(Domestic Irrigation, Municipal, Industrial, Other)

| Description & Color of Materials Sand, Clay, Red Clay, Shell, etc. | Thick- ness Feet | Depth Feet |
|-----------------------------------------------------------------------|------------------------|---------------|
| Clay | 17 | 17 |
| Sand | 60 | 77 |
| Coarse sand | 18 | 95 |
| Coarse sand & pea gravel | 12 | 107 |
| Sand and gravel | 12 | 119 |
| Coarse sand | 22 | 141 |
| Gravel | 3 | 144 |
| Clay | 14 | 158 |
| Sand & strks. clay | 51 | 209 |
| Rock | 1 | 210 |
| Sandy shale | 79 | 289 |
| Rock | 1 | 290 |
| Fine sand | 50 | 240 |
| Sand | 40 | 380 |
| Sand, strks. shale | 22 | 402 |
| Sand | 51 | 453 |


Information upon completion of well:

(1) Diameter 4x3 inches.
(2) Total Depth 453 feet.
(3) Water Level 15 feet below top of ground.
(4) Cased to 105', Size 4"
(5) Screen: Size 3", Length 30'
(6) Were any formations sealed against pollution?
X yes, no.

If YES depth of formation packer just above the screen.

Why

Drillers Remarks:

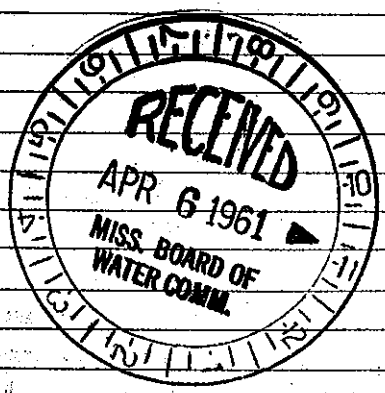

(Use Back Side)

Mail this copy to Board of Water Commissioners 429 Miss. St. Jackson, Miss.