

**BOLIVAR MISSISSIPPI BOARD OF WATER COMMISSIONERS**

0 46  
5-18-61

**WATER WELL DRILLERS LOG**

0 300

Date: 5/18, 1961, Driller: Delha W. Little Supply Co. County Bolivar  
(Name)

(1) Owner of Land:	Description & Color of Materials Sand, Clay, Red Clay, Shell, etc.	Thick- ness Feet	Depth Feet
<u>J. L. Wiggins</u> (Name) <u>Shaw - Miss</u> (Address)	<u>Top Soil &amp; Clay</u>	20	20
(2) Location: _____ 1/4, _____ 1/4, Sec. <u>26</u> T <u>21</u> R <u>7</u> ,	<u>Fine Sand &amp; Clay</u>	20	50
<u>7</u> miles <u>NE</u> of <u>Shaw</u> (distance) (direction) (Nearest Town)	<u>Sand Med</u>	20	70
(3) Topography: <u>Flat</u> (Hilly) (Flat) (Level)	<u>Sand &amp; Gravel</u>	47 <sup>4</sup>	117 <sup>4</sup>
(4) Purpose of Well: <u>Irrigation</u> (Domestic, Irrigation, Municipal, Industrial, Other)			


Information upon completion of well:

- (1) Diameter 12 inches.
- (2) Total Depth 117'-4" feet.
- (3) Water Level 16 feet below top of ground.
- (4) Cased to \_\_\_\_\_, Size \_\_\_\_\_.
- (5) Screen: Size 12, Length 40ft.
- (6) Were any formations sealed against pollution?  
\_\_\_\_\_ yes,  no.

If YES depth of formation \_\_\_\_\_

Why \_\_\_\_\_

Drillers Remarks: \_\_\_\_\_

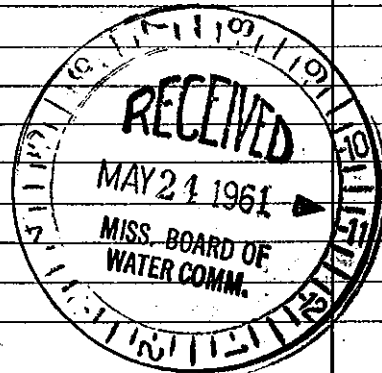

Well No. \_\_\_\_\_

(Use Back Side)

Mail this copy to Board of Water Commissioners 429 Miss. St. Jackson, Miss