


*Change P 83 to 853*  
**BOLIVAR** MISSISSIPPI BOARD OF WATER COMMISSIONERS *coded*

~~80~~ 53  
**8-9-62**

**WATER WELL DRILLERS LOG** *8/14/62* **CODED** *C1369R*

Date: August 9, 1962, Driller: Layne-Central Company County Bolivar  
(Name)

(1) Owner of Land: <u>G. W. Litton</u> (Name)	Description & Color of Materials Sand, Clay, Red Clay, Shell, etc.	Thick- ness Feet	Depth Feet
<u>Shaw, Mississippi</u> (Address)	Clay	14	14
(2) Location: <u>1/4, 1/4, Sec. 26 T21N R7W</u>	Fine brown sand	11	25
<u>_____</u> miles, of <u>Litton</u>	Coarse sand	35	60
(distance) (direction) (Nearest Town)	Coarse sand, pea gravel	18	78
(3) Topography: <u>flat</u>			
(Hilly) (Flat) (Level)			
(4) Purpose of Well: <u>industrial</u>			
(Domestic Irrigation Municipal, Industrial, Other)			
Information upon completion of well:			
(1) Diameter <u>3</u> inches.			
(2) Total Depth <u>78' 8"</u> feet.			
(3) Water Level <u>17' 7"</u> feet below top of ground.			
(4) Cased to <u>69' 9"</u> , Size <u>3"</u>			
(5) Screen: Size <u>3"</u> , Length <u>15' 11"</u>			
(6) Were any formations sealed against pollution?			
<u>yes</u> yes, <u>no</u> no.			
If YES depth of formation _____			
Why <u>Sanitary well top at the top.</u>			
To <u>eliminate all other formations.</u>			
Drillers Remarks: _____			
_____			
_____			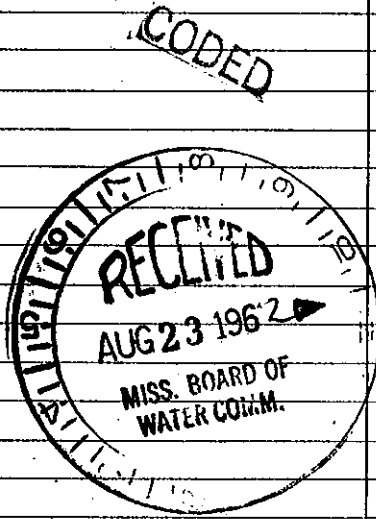
Well No.

(Use Back Side)

Mail this copy to Board of Water Commissioners 429 Miss. St. Jackson, Mis