

BOLIVAR

MISSISSIPPI BOARD OF WATER COMMISSIONERS

55

12-11-61 WATER WELL DRILLERS LOG

CODED 3-3

Date: December 11, 1961, Driller: Layne-Central Company, County Bolivar

(Name)

(1) Owner of Land: Mills Brothers
(Name)

Benoit, Mississippi
(Address)

(2) Location: 1/4, 1/4, Sec. 29 T21N R7W

3 1/2 miles east of Benoit
(distance) (direction) (Nearest Town)

(3) Topography: flat
(Hilly) (Flat) (Level)

(4) Purpose of Well: domestic
(Domestic Irrigation, Municipal, Industrial, Other)

Description & Color of Materials Sand, Clay, Red Clay, Shell, etc.	Thick- ness Feet	Depth Feet
Clay	30	30
Fine sand	25	55
Coarse sand & pea gravel	82	137
Clay	2	139
Coarse sand	71	210
Clay	60	270
Sandy shale	33	303
Clay	92	395
Sandy clay	24	419
Clay	11	430
Fine sand & clay streaks	79	509
Sand	46	557

Information upon completion of well:

(1) Diameter 4x3 inches.

(2) Total Depth 557 feet.

(3) Water level 18 feet below top of ground. 418' - 3"


(4) Cased to 105' - 4", Size 4"

(5) Screen: Size 30' - 4", Length 3"

(6) Were any formations sealed against pollution?
yes yes, no.

If YES depth of formation Sanitary Well Seal
Why To eliminate all other formations.

Drillers Remarks:

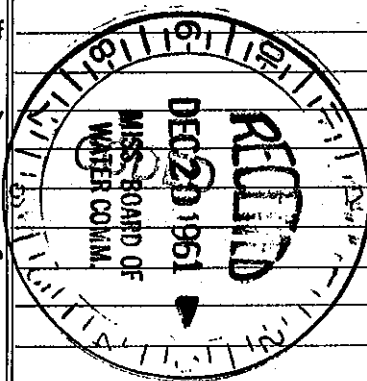

(Use Back Side)

Well No.