

058

10-66

WATER WELL DRILLERS LOG

Date: 10/24, 1944, Driller: Dalton Well & Supply Co. Belivar

(Name)

(1) Owner of Land: E. Litton
 (Name)
 RFD Benoit
 (Address)

(2) Location: SE 1/4, SW 1/4, Sec. 22 T21R7W
 5 miles East of Benoit
 (distance) (direction) (Nearest Town)

(3) Topography: (Hilly) (Flat) (Level)

(4) Purpose of Well: Domestic
 (Domestic Irrigation, Municipal, Industrial, Other)

Description & Color of Materials Sand, Clay, Red Clay, Shell, etc.	Thick- ness Feet	Depth Feet
Brick shot	16	15
Sand Fine	4	60
Sand & gravel	60	120
Clay	5	125
sand	12	137
Rough	3	140
Clay	17	157
Rough	2	159
Sand Fine	11	170
Clay	15	185
Rough	1	186
Clay	274	460
Sand Fine	30	490
Clay	15	505
Sand & Mud	40	545

Information upon completion of well:

(1) Diameter 4x2 inches.

(2) Total Depth 542 feet.

(3) Water Level 20 feet below top of ground.

(4) Cased to _____, Size _____

(5) Screen: Size 2", Length 20 ft.

(6) Were any formations sealed against pollution?
 _____ yes, no.


CODED

123 ft 4" gal pipe
 Bal. 2" " " "
 20 ft SS screen

If YES depth of formation _____

Why _____

Drillers Remarks: _____

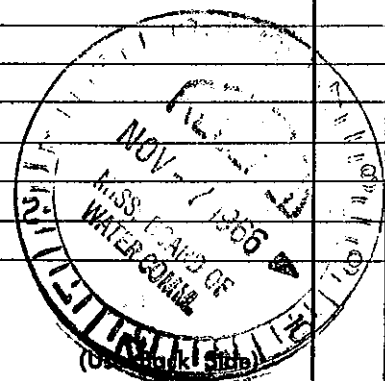

Well No.