

CODED

Bolivar
0 59
11-67

MISSISSIPPI
BOARD OF WATER COMMISSIONERS
416 North State Street
Jackson, Mississippi 39201

CODED

WATER WELL DRILLERS LOG

11/14 1967 Delta Well Supply Co Bolivar
date well completed firm name county well located

LANDOWNER:
M. B. Little
R. F. D. Shaw Miss.
(mailing address)

WELL LOCATION:
sec. 25 T. 21 N. R. 7 E. W.
7 miles East of Benoit
(distance) (direction) (nearest town)


WELL PURPOSE:
(home, irrigation, municipal, industrial)

WELL COMPLETION DATA:

- (1) diameter (inches) 4 1/2
- (2) total depth (feet) 1504
- (3) static water level (feet) 26 below above top of ground.
- (4) casing gal pipe 4 1/2
(material) (depth)
(size) if telescope see back.
- (5) screen 30 474
(length) (depth to top)
2 1/2 Stainless Steel
(size) (material)
- (6) pump 3 50+
(HP) (yield gpm)
elec
(type power)
- (7) electric log _____
(yes or no)
(organization running log)
- (8) how well bottom plugged B.P.V.

description of formations encountered	from	to
<u>Soft Clay</u>	<u>0</u>	<u>18</u>
<u>Fine Grained</u>	<u>18</u>	<u>75</u>
<u>sand & gravel</u>	<u>75</u>	<u>120</u>
<u>Rock</u>	<u>120</u>	<u>122</u>
<u>sand</u>	<u>122</u>	<u>130</u>
<u>Clay</u>	<u>130</u>	<u>190</u>
<u>sand</u>	<u>190</u>	<u>200</u>
<u>Clay</u>	<u>200</u>	<u>210</u>
<u>sand</u>	<u>210</u>	<u>230</u>
<u>Shale-sand Breck.</u>	<u>230</u>	<u>450</u>
<u>sand</u>	<u>450</u>	<u>510</u>
<u>Clay & shale</u>	<u>510</u>	<u>?</u>

CODED

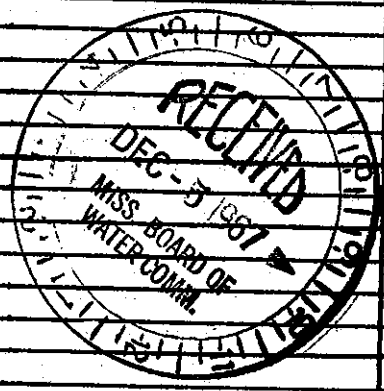

DRILLERS REMARKS: