

UNCODED CODED

MISSISSIPPI
BOARD OF WATER COMMISSIONERS
416 North State Street
Jackson, Mississippi 39201

H. J. 4/29/68
C2606
well #3

BOLIVAR
062
3-68

WATER WELL DRILLERS LOG

March 20, 1968 Layne Central Company Bolivar
date well completed firm name county well located


LANDOWNER: Allen Gray Estate	description of formations encountered	from	to
Benoit, Mississippi	Clay balls	17	46
(mailing address)	Coarse sand, pea gravel	46	60
WELL LOCATION: NW 1/4 SW 1/4	Coarse sand	60	66
sec 18 T 21 N R 7 E	Coarse sand, pea gravel	66	100
S	Coarse sand, gravel	100	119
Benoit	Clay	119	
(distance) miles of (direction) (nearest town)			

WELL PURPOSE: irrigation
(home, irrigation, municipal, industrial)

WELL COMPLETION DATA:

- (1) diameter (inches) 16
- (2) total depth (feet) 119
- (3) static water level (feet) 15' 2" above top of ground.
- (4) casing steel 59' (material), (depth)
16" (size) if telescope see back.
- (5) screen 60' (length), 119' (depth to top)
16" (size), Armco (material)
- (6) pump 60 (HP), 2500 (yield gpm)
electric (type power)
- (7) electric log no (yes or no)
(organization running log)
- (8) how well bottom plugged plate

CODED

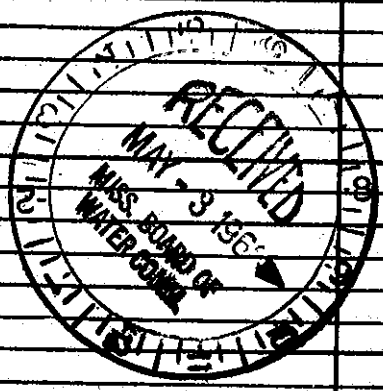

DRILLERS REMARKS: