

**SOLIVAR MISSISSIPPI BOARD OF WATER COMMISSIONERS**

**067**

**8-29-63**

**WATER WELL DRILLERS LOG**

**CODED**

Date: 8/29, 1963, Driller: Billy D. G. Co. County: Washington  
(Name)

(1) Owner of Land:	Description & Color of Materials Sand, Clay, Red Clay, Shell, etc.	Thick- ness Feet	Depth Feet
<u>Robert Clifton</u> <small>(Name)</small> <u>Benoit, Miss.</u> <small>(Address)</small>	<u>Clay</u>		<u>20</u>
(2) Location: <u>1/4, 1/4, Sec. 28 T4 R7</u>	<u>Sand</u>		<u>60</u>
<u>5</u> miles <u>SE</u> of <u>Benoit</u> <small>(distance) (direction) (Nearest Town)</small>	<u>Gravel</u>		<u>120</u>
(3) Topography: <u>Flat</u> <small>(Hilly) (Flat) (Level)</small>	<u>Mud</u>		<u>470</u>
(4) Purpose of Well: <u>Domestic</u> <small>(Domestic Irrigation Municipal, Industrial, Other)</small>	<u>Sand</u>		<u>503</u>

**Information upon completion of well:**

(1) Diameter 4 X 2 inches.

(2) Total Depth 503 feet.

(3) Water Level 18 feet below top of ground.

(4) Cased to all way Size 4 X 2.

(5) Screen: Size 2", Length 20'.


(6) Were any formations sealed against pollution?  
 \_\_\_\_\_ yes,  no.

If YES depth of formation \_\_\_\_\_

Why \_\_\_\_\_

Drillers Remarks: \_\_\_\_\_

**CODED**

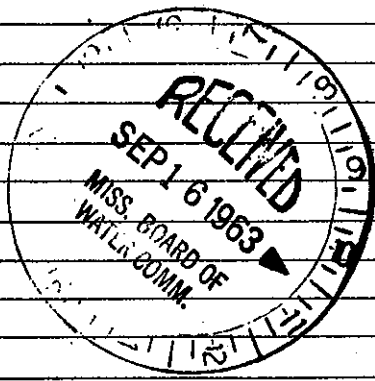

Well No.

(Use Back Side)

Mail this copy to Board of Water Commissioners 429 Miss. St. Jackson, Miss