

BOLIVAR
 CL-1832
Ø 92
5/6/81

MISSISSIPPI DEPARTMENT OF NATURAL RESOURCES
 Bureau of Land and Water Resources
 Southport Mall
 P.O. Box 10631
 Jackson, Mississippi 39208
WATER WELL DRILLERS LOG

CODED

5-6 1981 LAYNE-CENTRAL COMPANY BOLIVAR
 date well completed film name county well located


LANDOWNER:	description of formations encountered	from	to
CANADY FARMS			
Benoit, MS (mailing address)	coarse sand & gravel	71	122

WELL LOCATION:
 sec. 30 T 21 N R 2 E
2 miles EAST of Benoit
 (distance) (direction) (nearest town)

WELL PURPOSE: irrigation
 (home, irrigation, municipal, industrial)

- WELL COMPLETION DATA:
- (1) diameter (inches) 16"
 - (2) total depth (feet) 121'
 - (3) static water level (feet) 24 below top of ground.
 - (4) casing steel 71'
 (material) (depth)
16"
 (size) If telescope see back.
 - (5) screen 50' 71'
 (length) (depth to top)
16" st. steel
 (size) (material)
 - (6) pump 60 2500
 (HP) (yield gpm)
Diesel
 (type power)
 - (7) electric log no
 (yes or no)
 (organization running log) _____ st. plate
 - (8) how well bottom plugged _____

CODED

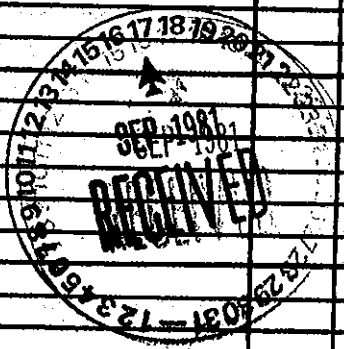

DRILLERS REMARKS: _____