

MISSISSIPPI DEPARTMENT OF NATURAL RESOURCES

Bureau of Land and Water Resources

Southport Mall

P.O. Box 10631

Jackson, Mississippi 39209

WATER WELL DRILLERS LOG

MS-GW-08087

EDWAN

Φ 98

Coded

4-15-88

Dyn Well

Bolivar

date well completed

firm name

county well located

LANDOWNER: Haris Sallyfield

Rt 1 Box 70
Bermit Ms 38725
(mailing address)

description of formations encountered

from

to

Clay	0	30
Fine Sand	30	40
Sand + Gravel	40	60
M Sand + Gravel	60	70
Sand + Gravel	70	90
Fine Sand	90	98
Sand + Gravel	98	120

WELL LOCATION:

sec. 22 T 21 N R 7 E
15 miles W of Shaw
(distance) (direction) (nearest town)

WELL PURPOSE: Irrigation
(home, irrigation, municipal, industrial)

WELL COMPLETION DATA:

(1) diameter (inches) 16"
(2) total depth (feet) 120'
(3) static water level (feet) _____ below
top of ground above


(4) casing steel
(material) (depth) _____
16
(size) If telescope see back.

(5) screen 40
(length) (depth to top)

16
(size) (material)
(6) pump 60 3000
(HP) (yield gpm)
Gear
(type power)

(7) electric log No
(yes or no)
Nova
(organization running log)

(8) how well bottom plugged Photo

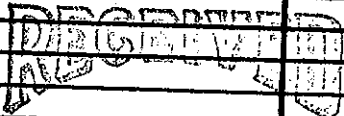

MAY 02 1988

Department of Natural Resources
Bureau of Land & Water Resources

DRILLERS REMARKS: