

State Well Report

Part 1

Mississippi Department of Environmental Quality
Office of Land and Water Resources
P.O. Box 10631
Jackson, MS 39289-0631
(601)961-5210
(601)354-6938 (fax)

County: BOLIVAR
Permit: GW 40582
Driller: SIDNEY COOK
Date drilling completed: 7/22/05

For Office Use Only:
Aquter: _____
Well #: φ-111
L.S. Elevation: _____
E-Log #: _____

State Law requires that this report be prepared by the driller in detail and filed with the Department within 30 days of completion of drilling of the well.

Well Owner Information	Well Location
Owner Name: <u>PARKER & SON</u>	Latitude: <u>N 33° 32.921' 37 55</u> Longitude: <u>W 90° 58.006'</u>
Mailing Address: <u>105 S FIFTH AVE</u>	Method of Lat/Long (circle one): <u>Conventional Survey</u> , USGS quad, <u>Hand-held GPS</u> , Survey-grade GPS
<u>CLEVELAND</u> MS <u>30732</u> City State Zip Code	<u>SE</u> 1/4 <u>SW</u> 1/4 Sec <u>30</u> TwN <u>21N</u> Rng <u>7W</u>
Telephone No. () _____	Distance <u>3</u> Miles Direction <u>NE</u> of Nearest Town <u>BENOIT</u>

Well Data

Purpose of Well (circle one) Home Industrial Public Supply Irrigation Fish Culture Other _____

Date well drilling started: 7/22/05 Date well drilling completed: 7/22/05

If flowing, method of flow regulation: Valve _____ Other (describe) _____

Static Water Level: 29 feet above or below (circle one) land surface Date measured: 7/22/05

Method of Measurement (circle one) Steel tape electric tape air line other: _____

Hole depth: 120 Well depth: 120 Well grouted to a depth of 10 feet

Type of grout (circle one): Cement Bentonite Mix

Casing Length: 80 feet Casing diameter: 10 inches Type of casing: PVC

Screen Length: 40 feet Screen diameter: 10 inches Type of screen: PVC

Screen slot size: .032 inches Setting depth: From 80 feet to 120 feet

Type of completion (circle all applicable): Gravel packed Underreamed Telescoped Open hole Natural Development
Other (describe): _____

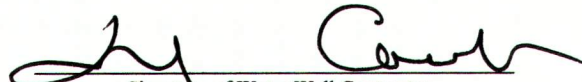
Top of lap pipe or reduction in casing: _____ feet **If telescoped or more than one screen, describe on back of page**

Logs run (circle all applicable): No log run Electric Gamma Ray Density Sonic Neutron Other: _____

Name of organization running log(s): _____

I certify that the well drilled, constructed, and completed in accordance with all applicable requirements of the Mississippi Department of Environmental Quality and/or the Mississippi Department of Health regulations and state laws.

Sidney Cook #0-289
Print Name of Water Well Contractor and License No.


Signature of Water Well Contractor

RECEIVED
AUG 22 2005
BY: OLWR

Q-111

If well telescopes please sketch below and show depths.

Ground Level

Description of Formations Encountered	From	To
Clay	0	35
Sand	35	56
Sand and Gravel	56	77
Heavy Sand & Gravel	77	120

If more than one screen, show location of each on sketch

Sketch the property layout and include the following: 1) the well location; 2) any permanent structures on the property that may aid in locating the well; 3) any roads, power lines, or other items that may aid in locating the property and the well; 4) indicate direction.

Landowner Name: Parker & Son Farms

Signature of Water Well Contractor: *Steve Coe*

RECEIVED
 AUG 22 2005
 BY: OLWR

STATE WELL REPORT

Part 2

Pump Installer's Completion Report
Mississippi Department of Environmental Quality
Office of Land and Water Resources
P.O. Box 10631
Jackson, MS 39289-0631
(601)961-5210
(601)354-6938 (fax)

County: BOLIVAR
Permit #: 40582
Driller: SIDNEY COOK
Date completed: 7/24/05

For Office Use Only:
Aquit: _____
Well #: Φ-111
Elevation: _____

This report should be prepared by the pump installer in detail and filed with Department within 30 days of the installation of pump.

Well Owner Information	Well Location
Owner Name <u>PARKER & SON</u>	Latitude: <u>N 33° 32.921'</u> Longitude: <u>W 90° 58.006'</u>
Mailing Address: <u>105 S FIFTH AVE</u>	Method of Lat/Long (circle one): <u>Conventional Survey</u> , USGS quad, <u>Hand-held GPS</u> , Survey-grade GPS
<u>CLEVELAND</u> MS <u>38732</u> City State Zip Code	<u>SE</u> ¼ <u>SW</u> ¼ Sec <u>30</u> Twn <u>21N</u> Rng <u>7W</u>
Telephone No. () _____	Distance Direction Nearest Town <u>3</u> Miles <u>NE</u> of <u>BENOIT</u>

Pump Type Circle one	Power Type Circle one
Air Lift Jet <u>Submersible</u>	Diesel Engine Gasoline Engine Natural Gas
Bucket Piston Turbine	<u>Electric Motor</u> Hand Tractor PTO
Centrifugal Rotary Flowing Well	Windmill Other (specify): _____
Other (specify): _____	Horse Power Rating of Motor: <u>30</u> HP
Date Pump Installed: <u>7/24/05</u>	Setting Depth: <u>70</u> feet
Rated Pump Capacity: <u>1800</u> Gallons Per Minute	Number of Stages: <u>1</u>

Pump Test Data	Method of Measuring Water Level Circle one
Date Well Tested: _____	Air Line Electric Measuring Line <u>Steel Tape</u>
Static Water Level (A): <u>29</u> Feet Below Land Surface	Other (specify): _____
Pumping Water Level (B): _____ Feet Below Land Surface	For flowing well, measured shut in head: _____ feet
Drawdown [(B)-(A)]: _____ Feet Below Land Surface	Well yielded _____ GPM with a drawdown of _____ feet after _____ hours of pumping
Test Pumping Rate: _____ Gallons Per Minute	
Duration of Pump Test (minimum 4 hours): _____ hours	

I HEREBY CERTIFY that the above statements are true to the best of my knowledge.

Matt Stephens #0-743P
Print Name of Pump Installer and License No. (if applicable)

Matt Stephens
Signature of Pump Installer

RECEIVED
AUG 22 2005
BY: OLWR