
	ll Report	For Office Use Only:
	rt 1	
Mississippi Department	of Environmental Quality	Aquifer:
	d Water Resources x 10631	Well #: <u>Q-116</u>
	S 39289-0631	L. S. Elevation:
	61-5210	
	-6938 (fax)	E-log #:
State Law requires that this report be prepared by the d 30 days of completion of drilling of the well.		
Well Owner Information	Wel	I Location
Owner Name Dahomey Plantation	Latitude: <u>33 • 41 • 35</u>	" Longitude: <u>90°57' 29</u> "
Mailing Address: C/O Jimmy Winemiccon		
114 Hickory CREEK Cinch		
Little Rock AR. 72212 City State Zip Code	NE 1/2 50 1/4 Sec_ (0	Twn LIN Rng IN
1	Distance Direction	Nearest Town
Telephone No. 501) (92-4-39/	<u>5</u> Miles NE	of BENOIT
Well D	lata	· · · · · · · · · · · · · · · · · · ·
Purpose of Well (circle one) Home Industrial Public Supply		
Date well drilling started: <u>4-16-07</u> Date w	vell drilling completed: 4	-16-07
If flowing, method of flow regulation: Valve Other (de	escribe)	
Static Water Level: <u>30</u> feet above or below (circle one) la	and surface Date measured:	·
Method of Measurement (circle one) (steel tape) electric tape		
Hole depth: Well depth:		
Type of grout (circle one): Cement (Bentonite) Mix		
Casing length: <u>85</u> feet Casing diameter: <u>16</u>	inches Type of casing:	PUC
Screen length: <u>40</u> feet Screen diameter: <u>16</u>		
Screen slot size: <u>-050</u> inches Setting depth: From _	-	
Type of completion (circle all applicable): Gravel packed Under		
Other (describe):	••••••••••••••••••••••••••••••••••••••	
Top of lap pipe or reduction in casing:feet. If te	lescoped or more than one so	reen, describe on back of page
Logs run (circle all applicable): No log run Electric Gamma Ray	Density Sonic Neutron	Other:
Name of organization running log(s):		· ·
I certify that the well was drilled, constructed, and completed in a	eccordance with all applicabl	e requirements of the Mississippi
Department of Environmental Quality and/or the Mississippi Dep		• • •
AHAGGER Well SURVice (542)	X Games	Hangel
THE ALL AND AL		C I I VERVING
Print Name of Water Well Contractor and License No.		of Water Wen Contractor

• /

RECEIVED

If well telescopes please sketch below and show depths.




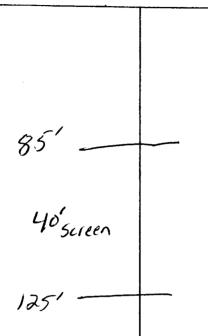

Description of Formations Encountered	From	То
Class	6	
Clay	-10-	25
Clay sand mix	25	60
fine	60	80
Medium	80	105
Rock	105	112
Medium Louise	112	125
Solid Rock		
	_	
		├ ───┤
	_	
L		

If more than one screen, show location of each on sketch

Signature of Water Well Copyrictor

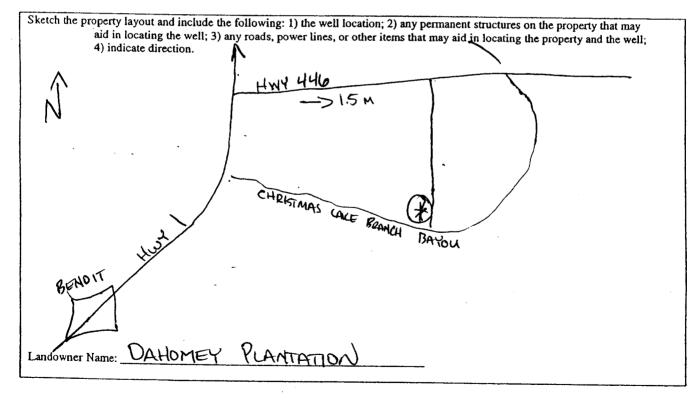

3	ULALL WE		
County: BOLi DAN Permit #: GW 41979 Driller Ames Haccan Date completed 4-16-07	Part 2 Pump Installer's Completion Report Mississippi Department of Environmental Quality Office of Land and Water Resources		For Office Use Only: Aquifer: Well #: Elevation:
This report should be prepared by the installation of pump.		and filed with the Departme	nt within 30 days of the
Owner Name Attomsy Lant			Longitud 90 -57 - 29
Mailing Address Clo J: mnug 4 14 Hickory C L: TLG Rock QM City State Telephone No. 501, 692 - 439	Diw Millen LEEK ARUE 2.722/2 Zip Code	Method of Lat/Long (circle or USGS quad, Han <u>NE</u> 14 <u>S</u> <u>14</u> Sec_ Distance Direction	
Pump Type Circle one Air Lift Jet	Submersible		ower Type Circle one ne Engine Natural Gas
Bucket Piston (Turbine	Electric Motor Hand	Tractor PTO
Centrifugal Rotary Other (specify):	Flowing Well		(specify):
Date Pump Installed: 5-2-07 Rated Pump Capacity: 5-2-07	Gallons Per Minute	Horse Power Rating of Moto Setting Depth: Number of Stages:	r:feet
3006			
Pump Test Data			easuring Water Level Circle one
Pump Test Data Date Well Tested: Static Water Level (A):Feet	Below Land Surface		Circle one asuring Line Steel Tape
Pump Test Data Date Well Tested: Static Water Level (A): Pumping Water Level (B): Freet	Below Land Surface Below Land Surface Below Land Surface	Air Line Electric Me Other (specify):	Circle one asuring Line Steel Tape

I HEREBY CERTIFY that the above statements are true to the best of my kno CHEN KOWE #710 P	Wiedge.
Print Name of Pump Installer and License No. (if applicable)	Signature of Pump Installer

JUL 16 2007 BY: OLWR