

**DAHOMEY # 3
State Well Report**

Part 1

Mississippi Department of Environmental Quality
Office of Land and Water Resources
P.O. Box 10631
Jackson, MS 39289-0631
(601)961-5210
(601)354-6938 (fax)

For Office Use Only:

Aquifer: _____
Well #: Q-124
L. S. Elevation: _____
E-log #: _____

County: BOLIVAR
Permit #: 6042633
Driller: J. NEWOME 0-773
Date drilling completed: 5-22-08

State Law requires that this report be prepared by the driller in detail and filed with the Department within 30 days of completion of drilling of the well.

Well Owner Information	Well Location
Owner Name: <u>DAHOMEY PLANTATION</u>	Latitude: <u>33-40-02"</u> Longitude: <u>90-57-47"</u>
Mailing Address: <u>114 HICKORY CREEK CIRCLE</u> <u>LITTLE ROCK AR. 72212</u>	Method of Lat/Long (circle one): Conventional Survey, USGS quad, <u>Hand-held GPS</u> , Survey-grade GPS
City: _____ State: _____ Zip Code: _____	SW 1/4 NE 1/4 Sec <u>18</u> Twn <u>21N</u> Rng <u>TW</u>
Telephone No. <u>501-666-9280</u>	Distance <u>2.5</u> Miles Direction <u>NE</u> of Nearest Town <u>BENOIT</u>

Well Data

Purpose of Well (circle one) Home Industrial Public Supply Irrigation Fish Culture Other: _____

Date well drilling started: 5-22-08 Date well drilling completed: 5-22-08

If flowing, method of flow regulation: Valve _____ Other (describe) _____

Static Water Level: _____ feet above or below (circle one) land surface Date measured: _____

Method of Measurement (circle one) steel tape electric tape air line other: _____

Hole depth: 133 Well depth: 130 Well grouted to a depth of 10 feet

Type of grout (circle one): Cement Bentonite Mix

Casing length: 100 feet Casing diameter: 16 inches Type of casing: P.U.C.

Screen length: 30 feet Screen diameter: 16 inches Type of screen: P.U.C.

Screen slot size: .050 inches Setting depth: From 80-90 feet to 110-130 feet

Type of completion (circle all applicable): Gravel packed Underreamed Telescoped Open hole Natural Development

Other (describe): _____

Top of lap pipe or reduction in casing: _____ feet. If telescoped or more than one screen, describe on back of page

Logs run (circle all applicable): No log run Electric Gamma Ray Density Sonic Neutron Other: _____

Name of organization running log(s): _____

I certify that the well was drilled, constructed, and completed in accordance with all applicable requirements of the Mississippi Department of Environmental Quality and/or the Mississippi Department of Health regulations and state laws.


JOHN NEWOME 0-773
Print Name of Water Well Contractor and License No.

[Signature]
Signature of Water Well Contractor

RECEIVED
JUL 02 2008
BY: OLWR

2-124


If well telescopes please sketch below and show depths.

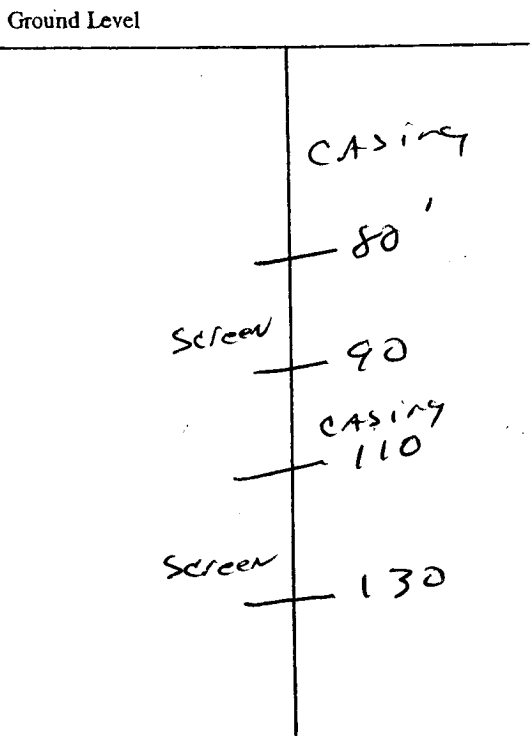

Description of Formations Encountered	From	To
TOP Soil	0	10
Mix CLAY	10	48
Fine Sand	48	80
Med. Coarse Sand	80	90
Fine Sand	90	110
Med. Coarse Sand	110	130
Gray CLAY	130	133

If more than one screen, show location of each on sketch

Sketch the property layout and include the following: 1) the well location; 2) any permanent structures on the property that may aid in locating the well; 3) any roads, power lines, or other items that may aid in locating the property and the well; 4) indicate direction.

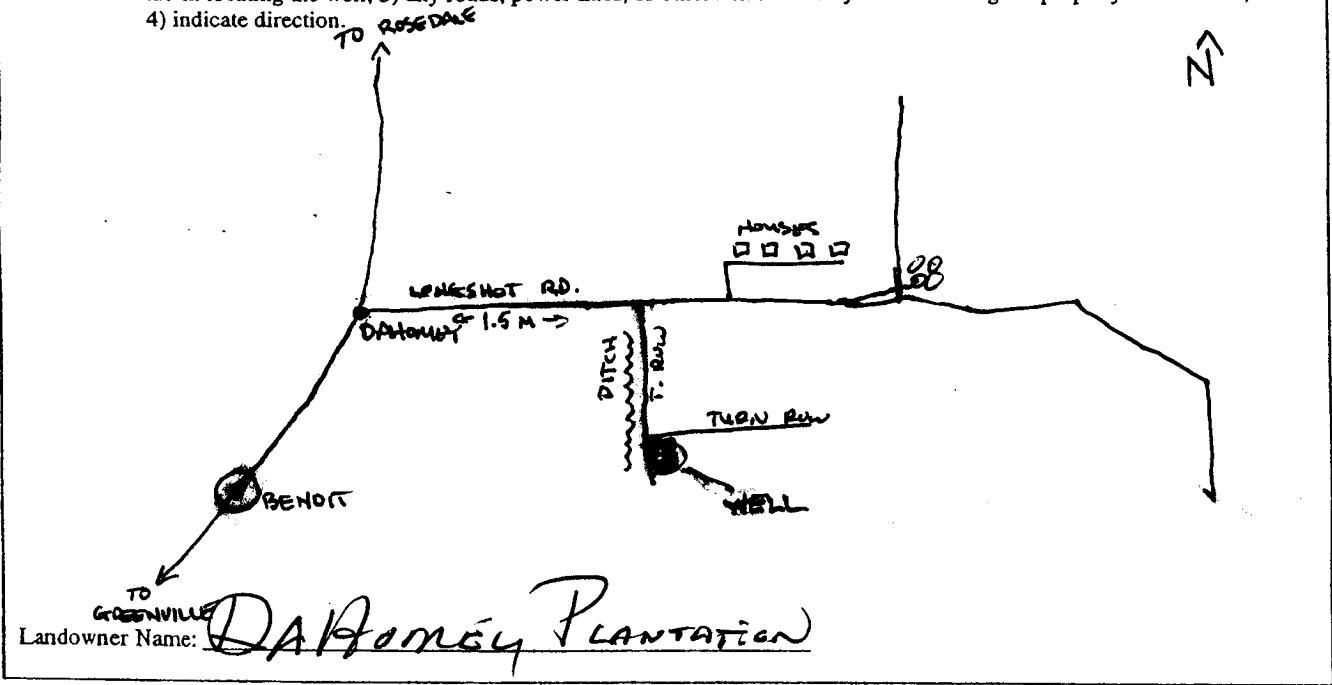

[Signature]
 Signature of Water Well Contractor

STATE WELL REPORT

Part 2

Pump Installer's Completion Report
 Mississippi Department of Environmental Quality
 Office of Land and Water Resources
 P.O. Box 10631
 Jackson, MS 39289-0631
 (601)961-5210
 (601)354-6938 (fax)

For Office Use Only:	
Aquifer: _____	Well #: <u>Q-124</u>
Elevation: _____	

County: <u>Bolivar</u>
Permit #: <u>61042633</u>
Driller: <u>J. NEWCOMB - 773</u>
Date completed: <u>5-22-08</u>


This report should be prepared by the pump installer in detail and filed with the Department within 30 days of the installation of pump.

Well Owner Information	Well Location
Owner Name: <u>DATOMEY PLANTATION</u>	Latitude: <u>33-40-02</u> Longitude: <u>090-57-47</u>
Mailing Address: <u>114 Hickory Creek Circle</u>	Method of Lat/Long (circle one): Conventional Survey, <u>Hand-held GPS</u>
<u>Little Rock, AR. 72212</u>	USGS quad: <u>SW 1/4 NE 1/4 Sec 18 Twp 21N Rng 7W</u>
City: _____ State: _____ Zip Code: _____	Distance: <u>2.5</u> Miles Direction: <u>NE</u> of Nearest Town: <u>Benoit</u>
Telephone No.: <u>501-466-9280</u>	

Pump Type Circle one	Power Type Circle one
Air Lift: Jet <input type="checkbox"/> Submersible <input type="checkbox"/>	<u>Diesel Engine</u> Gasoline Engine <input type="checkbox"/> Natural Gas <input type="checkbox"/>
Bucket: Piston <input type="checkbox"/> <u>Turbine</u> <input checked="" type="checkbox"/>	Electric Motor <input type="checkbox"/> Hand <input type="checkbox"/> Tractor PTO <input type="checkbox"/>
Centrifugal: Rotary <input type="checkbox"/> Flowing Well <input type="checkbox"/>	Windmill <input type="checkbox"/> Other (specify): _____
Other (specify): _____	Horse Power Rating of Motor: <u>60</u>
Date Pump Installed: <u>5-29-08</u>	Setting Depth: <u>70</u> feet
Rated Pump Capacity: <u>3000</u> Gallons Per Minute	Number of Stages: <u>1</u>

Pump Test Data	Method of Measuring Water Level Circle one
Date Well Tested: _____	Air Line <input type="checkbox"/> Electric Measuring Line <input type="checkbox"/> Steel Tape <input type="checkbox"/>
Static Water Level (A): <u>NOT TESTED</u> Feet Below Land Surface	Other (specify): _____
Pumping Water Level (B): <u>NOT TESTED</u> Feet Below Land Surface	For flowing well, measured shut in head: _____ feet
Drawdown [(B) - (A)]: _____ Feet Below Land Surface	Well yielded _____ GPM with a drawdown of _____ feet after _____ hours of pumping
Test Pumping Rate: _____ Gallons Per Minute	
Duration of Pump Test (minimum 4 hours): _____ hours	

I HEREBY CERTIFY that the above statements are true to the best of my knowledge.
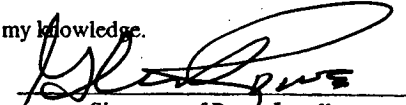
<u>GLEN ROWE 710-P</u> Print Name of Pump Installer and License No. (if applicable)	 Signature of Pump Installer
--	---

RECEIVED
 JUL 02 2008
 BY: OLWR